


WESTWINDS

269 SW WESTWINDS

COPY

SW Westwinds Rd, 269 (Arborgast)
2019.0149.BP

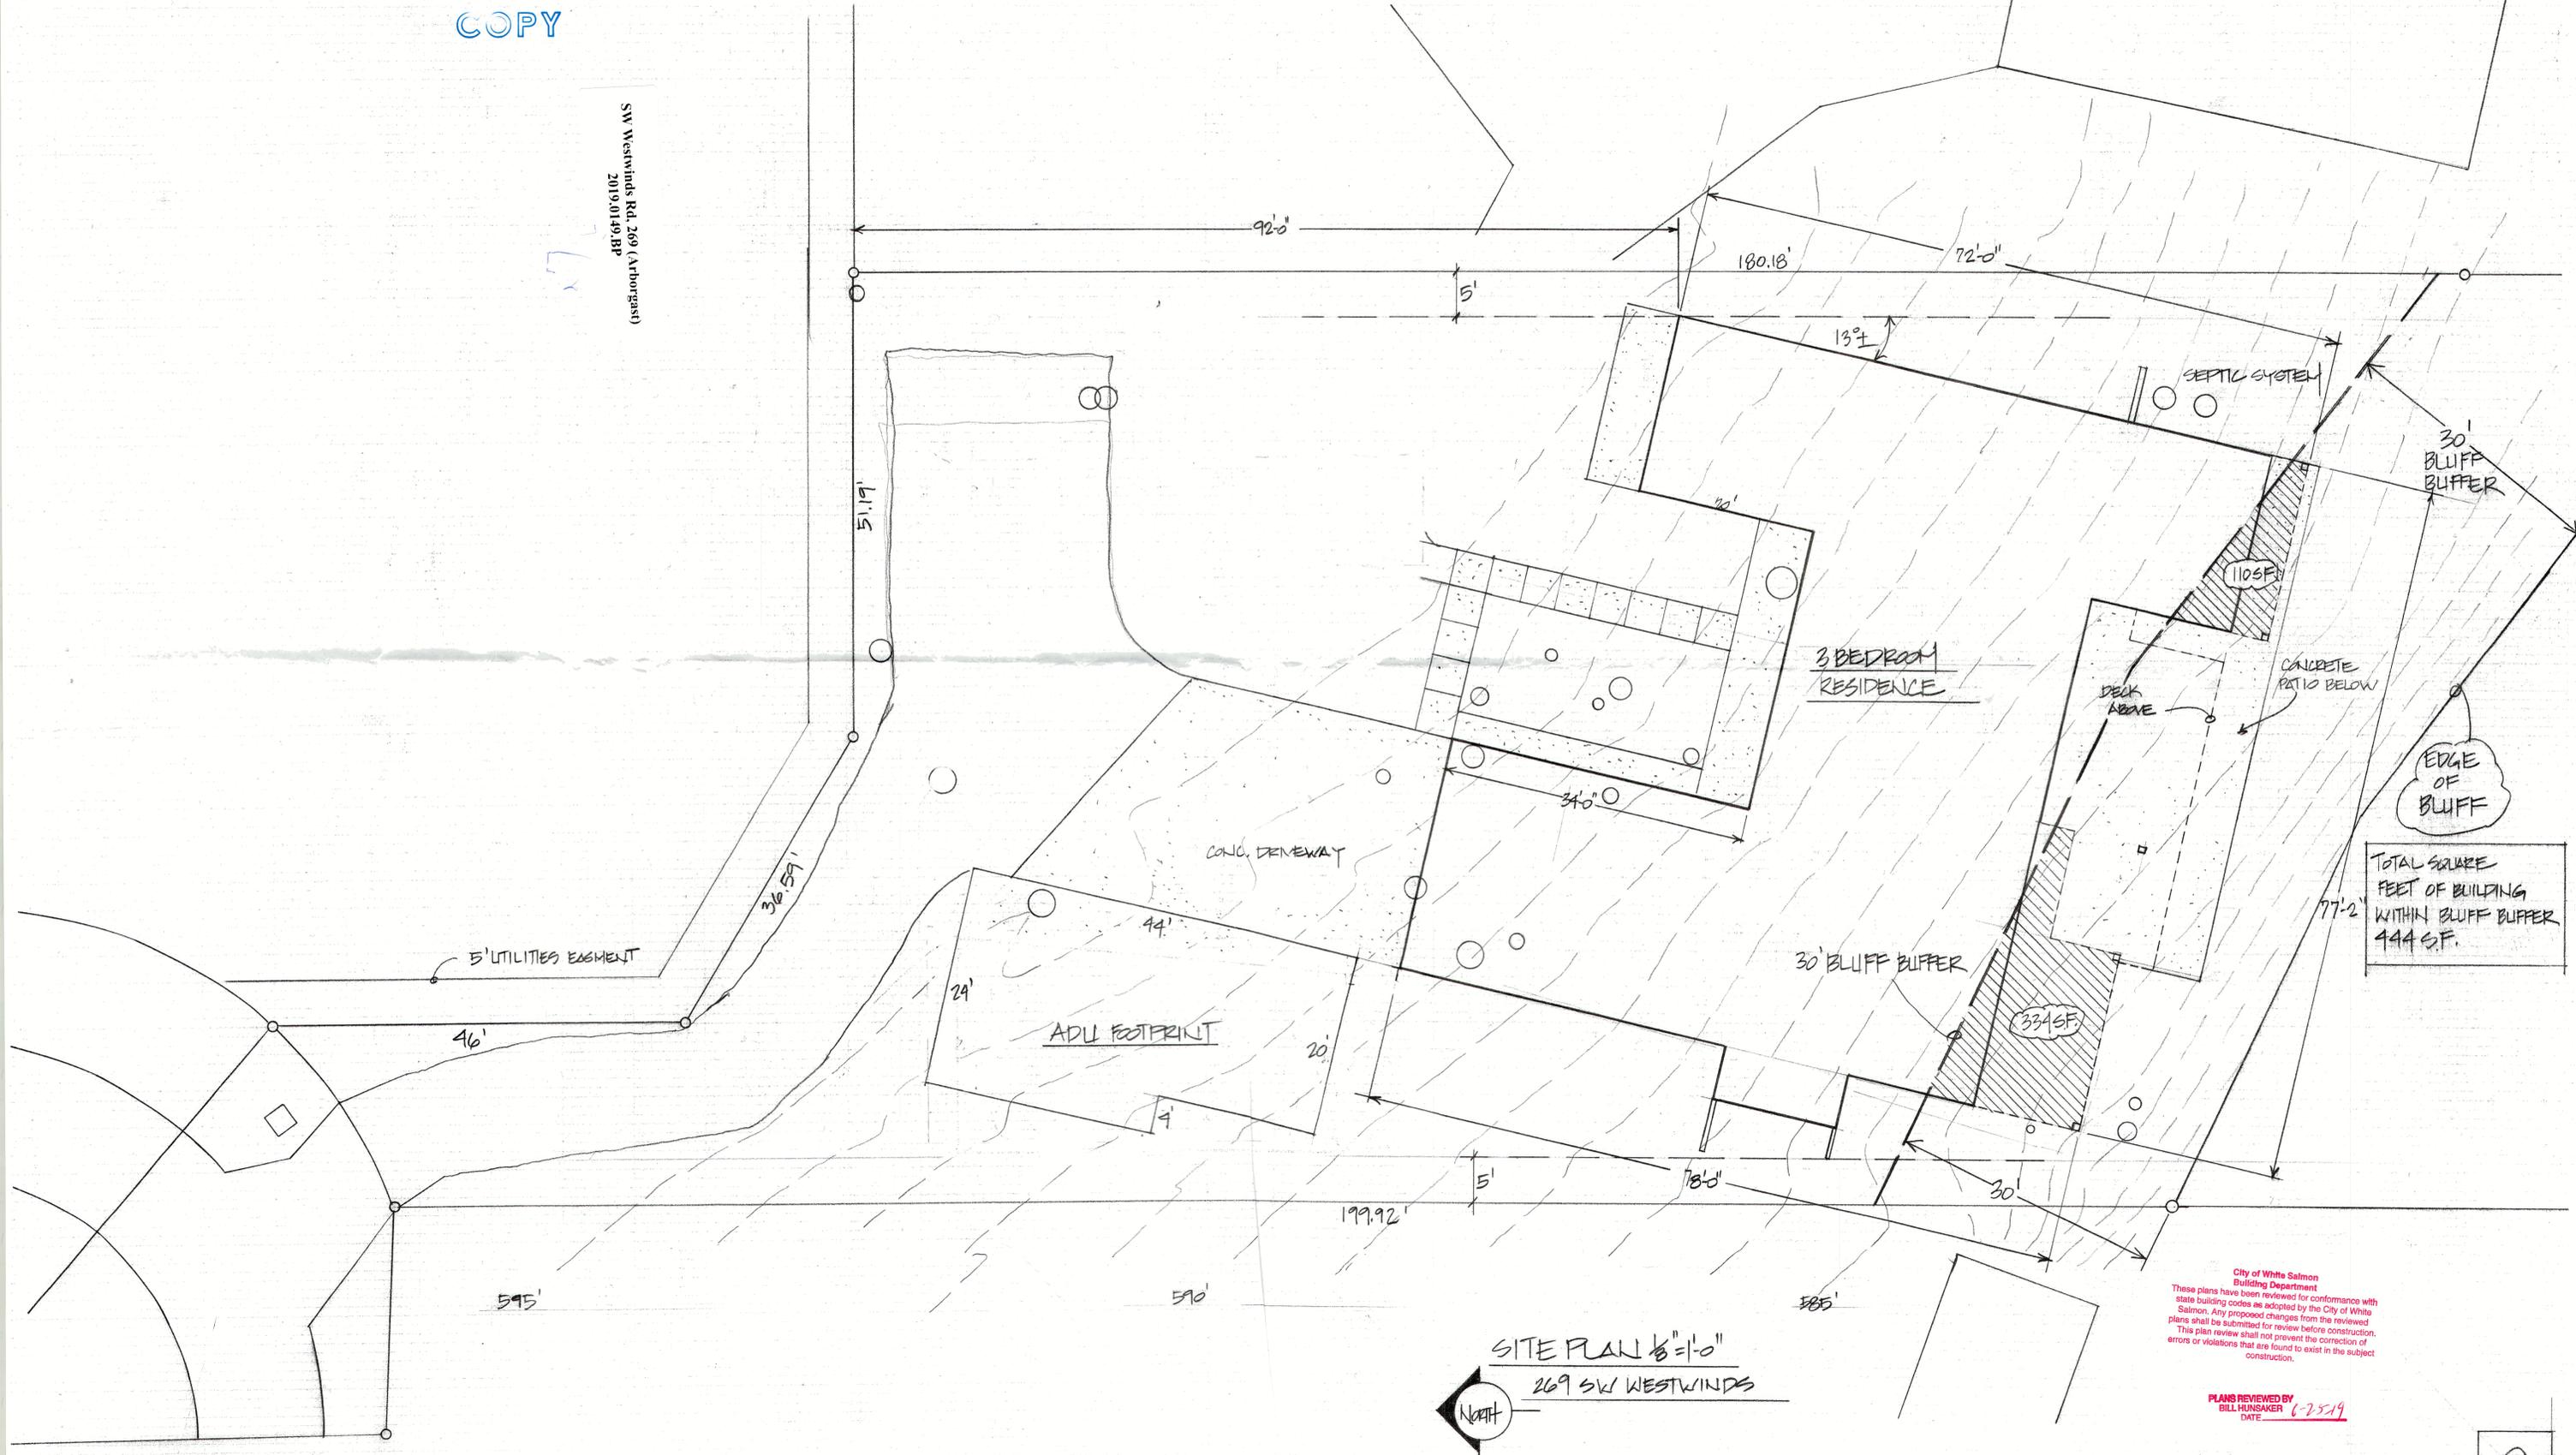

TOTAL SQUARE FEET OF BUILDING WITHIN BLUFF BUFFER 444 SF.


SITE PLAN 1/8" = 1'-0"
269 SW WESTWINDS



City of White Salmon
Building Department
These plans have been reviewed for conformance with state building codes as adopted by the City of White Salmon. Any proposed changes from the reviewed plans shall be submitted for review before construction. This plan review shall not prevent the correction of errors or violations that are found to exist in the subject construction.

PLANS REVIEWED BY
BILL HUNSAKER
DATE 6-25-19

S
5/1

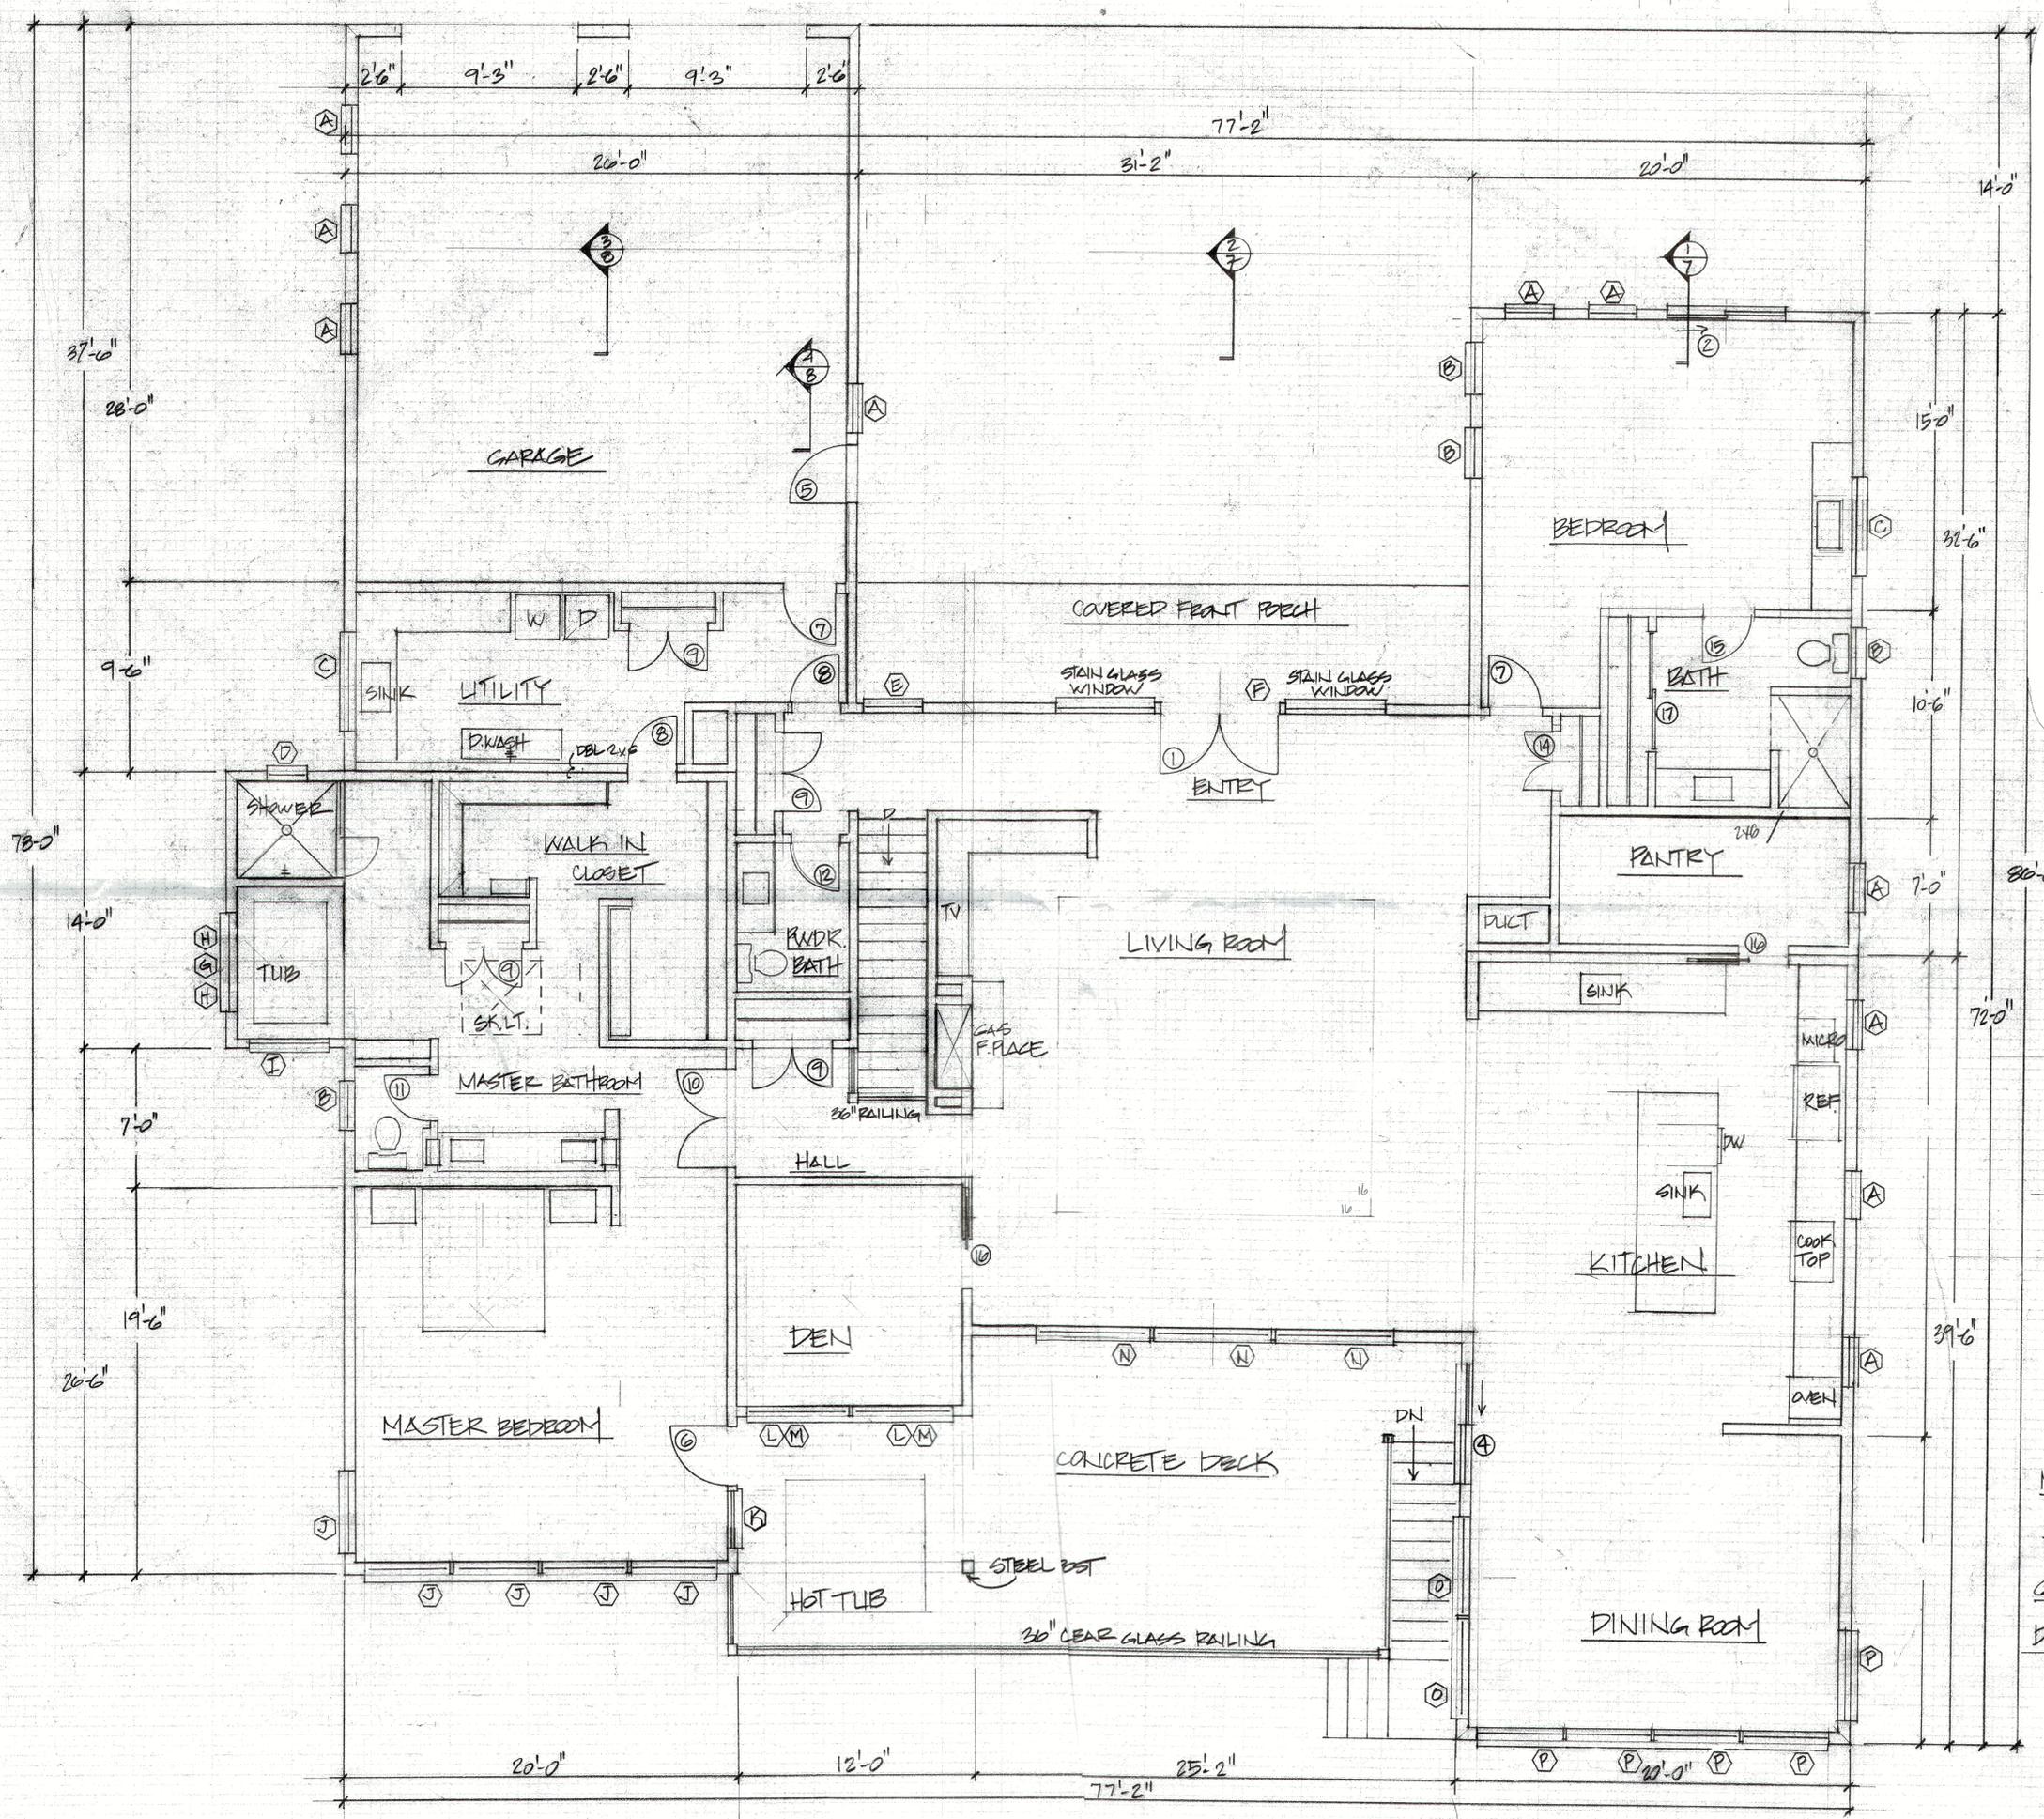


WINDOWS and Doors		Arbogast Gottlieb			
Huberd Design and Construction		May 6, 2019			
PO box 827 Hood River OR 97031					
jim@huberddesign.com Mobile 541-340-0644					
WINDOWS					
QTY	Size	Style	Jamb	Notes	
A	11 30" x 30"	PIC	2 X 6		
B	8 30" x 30"	AWNING	2 X 6		
C	3 60" x 42"	DBL CASEMENT	2 X 6		
D	1 24" x 24"	PIC	2 X 6		
E	1 36" x 72"	PIC	2 X 6		
F	1 72" x 42"	PIC	2 X 6		
G	1 60" x 36"	PIC	2 X 6	TEMPERED	
H	2 30" x 18"	AWNING	2 X 6	TEMPERED	
I	1 48" x 54"	PIC	2 X 6	TEMPERED	
J	5 51" x 60"	PIC	2 X 6		
K	1 36" x 60"	PIC	2 X 6	TEMPERED	
L	2 60" x 60"	PIC	2 X 6	TEMPERED	
M	2 60" x 18"	AWNING	2 X 6	TEMPERED	
N	3 72" x 120"	PIC	2 X 6	TEMPERED	
O	2 60" x 72"	PIC	2 X 6	TEMPERED	
P	5 51" x 72"	PIC	2 X 6		
R	6 60" x 60"	PIC	2 X 6		
Tot 54					
DOORS					
QTY	Size	Style	Jamb	Swing	Notes
1	1 6'-0" x 8'-0"	DBL DOOR	2 X 6	IN	MAIN ENTRY
2	1 6'-0" x 7'-0"	SLIDER	2 X 6	XO	EXTERIOR
3	2 6'-0" x 7'-0"	SLIDER	2 X 6	OX	EXTERIOR
4	1 6'-0" x 8'-0"	SLIDER	2 X 6	OX	EXTERIOR
5	1 3'-0" x 7'-0"	FLUSH	2 X 6	LH	EXTERIOR
6	1 3'-0" x 7'-0"	FULL LIGHT	2 X 6	RH	EXTERIOR
7	2 2'-8" x 7'-0"	INTERIOR	2 X 6	LH	HOUSE TO GARAGE
8	3 2'-8" x 7'-0"	INTERIOR	2 X 6	RH	
9	4 4'-0" x 7'-0"	INT DBL DOOR	2 X 4		
10	1 5'-0" x 7'-0"	INT DBL DOOR	2 X 6		MASTER BEDROOM
11	1 2'-4" x 7'-0"	INTERIOR	2 X 4	RH	
12	1 2'-4" x 7'-0"	INTERIOR	2 X 4	LH	
13	1 2'-8" x 7'-0"	INTERIOR	2 X 4	LH	
14	1 3'-0" x 7'-0"	INT DBL DOOR	2 X 4		
15	1 2'-8" x 7'-0"	INTERIOR	2 X 4	RH	
16	2 2'-8" x 7'-0"	INTERIOR POCKET	2 X 6		
17	2 6'-0" x 7'-0"	BI PASS	2 X 4		
18	2 2'-4" x 7'-0"	INTERIOR	2 X 6	LH	
19	1 3'-0" x 7'-0"	INTERIOR	2 X 6	RH	
20	1 3'-0" x 7'-0"	INTERIOR	2 X 6	LH	
21	1 3'-0" x 7'-0"	INTERIOR	2 X 4	RH	
Tot 31					

MAIN FLOOR PLAN 1/4"=1'-0"
 3768 S.F.
 GARAGE 728 S.F.
 DECK 544 S.F.


WINDOWS				
QTY	Size	Style	Jamb	Notes
A	11 30" x 30"	PIC	2 X 6	
B	6 30" x 30"	AWNING	2 X 6	
C	3 60" x 42"	DBL CASEMENT	2 X 6	
D	1 24" x 24"	PIC	2 X 6	
E	1 36" x 72"	PIC	2 X 6	
F	1 72" x 42"	PIC	2 X 6	
G	1 60" x 36"	PIC	2 X 6	TEMPERED
H	2 30" x 18"	AWNING	2 X 6	TEMPERED
I	1 48" x 54"	PIC	2 X 6	TEMPERED
J	5 51" x 60"	PIC	2 X 6	
K	1 36" x 60"	PIC	2 X 6	TEMPERED
L	2 60" x 60"	PIC	2 X 6	TEMPERED
M	2 60" x 18"	AWNING	2 X 6	TEMPERED
N	3 72" x 120"	PIC	2 X 6	TEMPERED
O	2 60" x 72"	PIC	2 X 6	TEMPERED
P	5 51" x 72"	PIC	2 X 6	
R	6 60" x 60"	PIC	2 X 6	
Tot	64			

DOORS					
QTY	Size	Style	Jamb	Swing	Notes
1	6'-0" x 8'-0"	DBL DOOR	2 X 6	IN	MAIN ENTRY
2	6'-0" x 7'-0"	SLIDER	2 X 6	XO	EXTERIOR
3	6'-0" x 7'-0"	SLIDER	2 X 6	OX	EXTERIOR
4	6'-0" x 8'-0"	SLIDER	2 X 6	OX	EXTERIOR
5	3'-0" x 7'-0"	FLUSH	2 X 6	LH	EXTERIOR
6	3'-0" x 7'-0"	FULL LIGHT	2 X 6	RH	EXTERIOR
7	2'-8" x 7'-0"	INTERIOR	2 X 6	LH	HOUSE TO GARAGE
8	2'-8" x 7'-0"	INTERIOR	2 X 6	RH	
9	4'-0" x 7'-0"	INT. DBL DOOR	2 X 4		
10	5'-0" x 7'-0"	INT. DBL DOOR	2 X 6		MASTER BEDROOM
11	2'-4" x 7'-0"	INTERIOR	2 X 4	RH	
12	2'-4" x 7'-0"	INTERIOR	2 X 4	LH	
13	2'-8" x 7'-0"	INTERIOR	2 X 4	LH	
14	3'-0" x 7'-0"	INT. DBL DOOR	2 X 4		
15	2'-8" x 7'-0"	INTERIOR	2 X 4	RH	
16	2'-8" x 7'-0"	INTERIOR POCKET	2 X 6		
17	6'-0" x 7'-0"	BI PASS	2 X 4		
18	2'-4" x 7'-0"	INTERIOR	2 X 6	LH	
19	3'-0" x 7'-0"	INTERIOR	2 X 6	RH	
20	3'-0" x 7'-0"	INTERIOR	2 X 6	LH	
21	3'-0" x 7'-0"	INTERIOR	2 X 4	RH	
Tot	31				

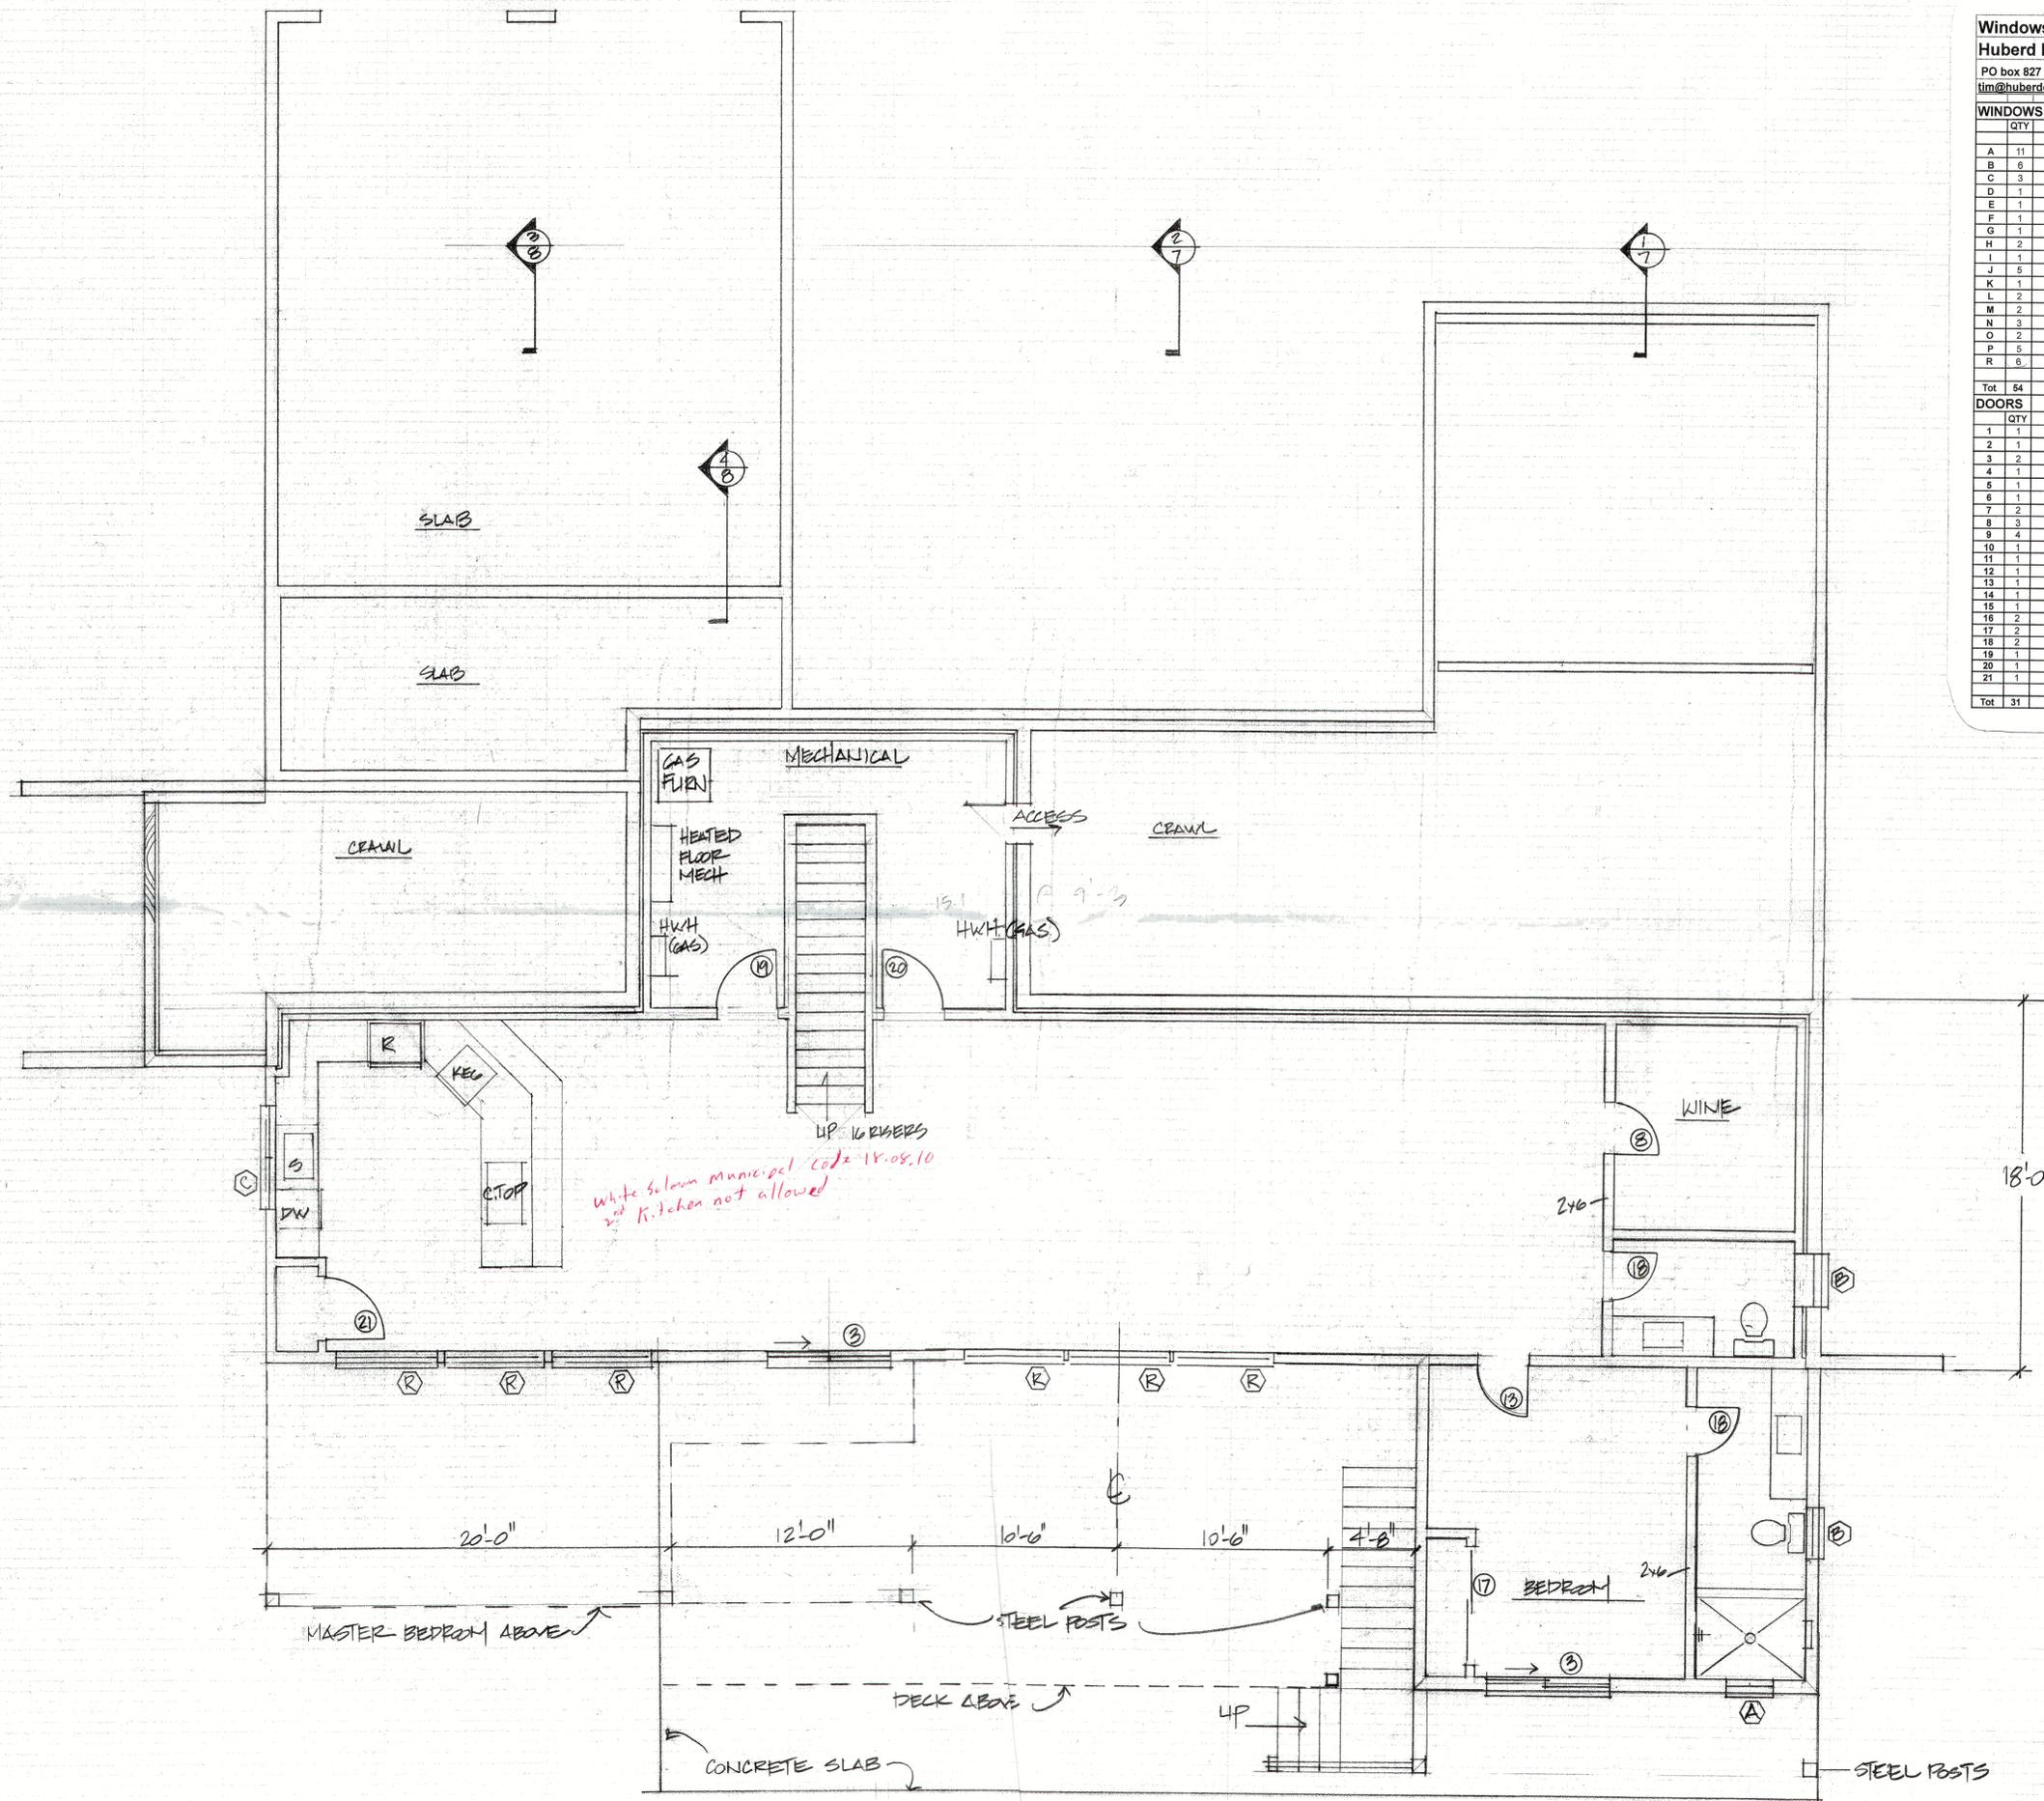


14.5 x 15.6 = 229.75
 17 x 17 = 1309
 20 x 20 = 400
 1934 SF


BASEMENT 1/4" = 1'-0"
 1934 SF

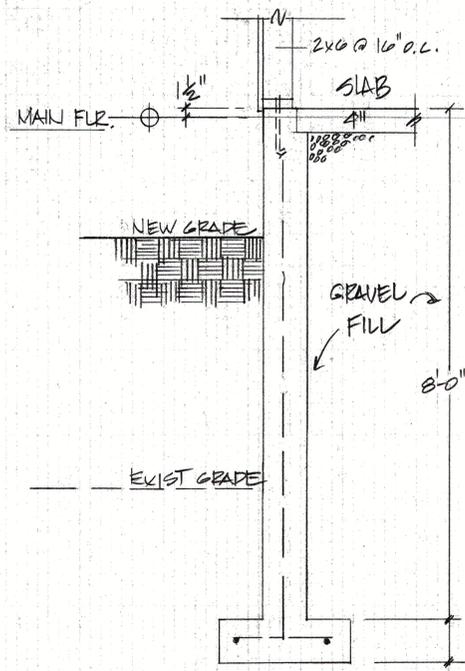


Ⓐ DETAIL $\frac{3}{4}'' = 1'-0''$

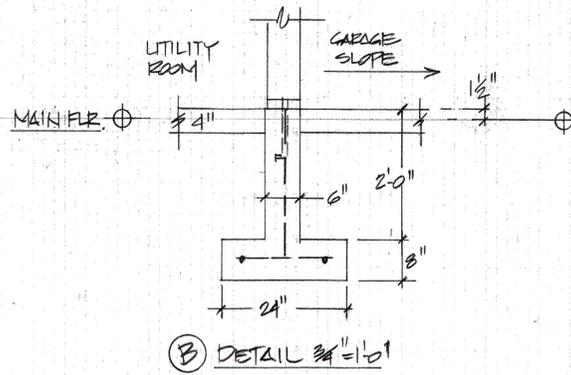


Ⓑ DETAIL $\frac{3}{4}'' = 1'-0''$

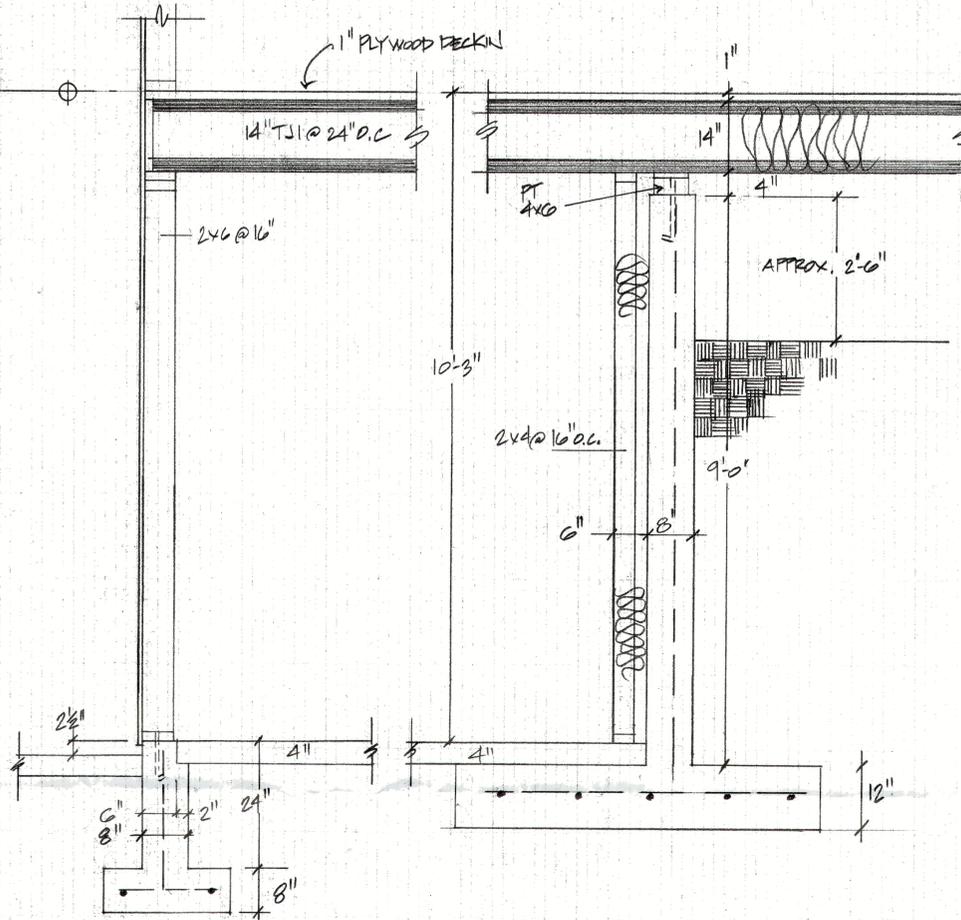


Ⓒ DETAIL $\frac{3}{4}'' = 1'-0''$

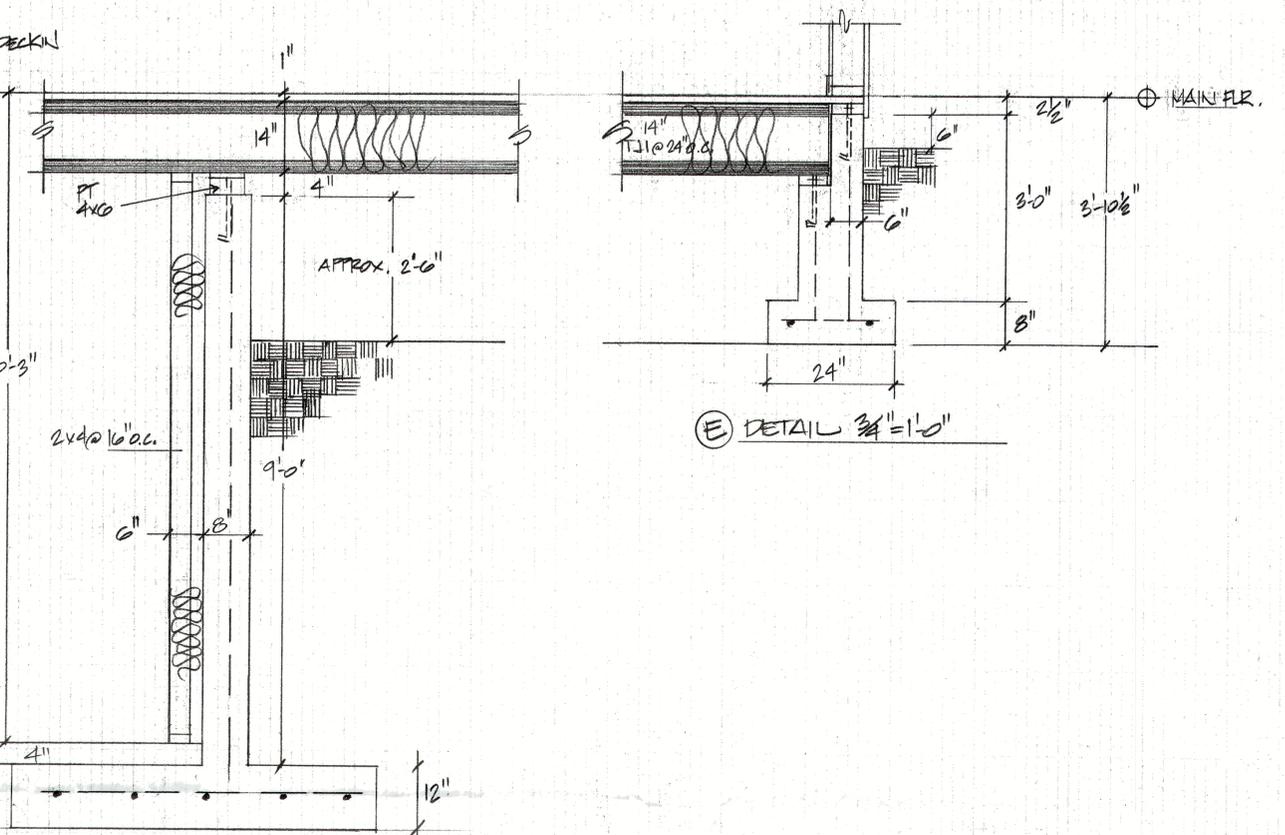


Ⓓ DETAIL $\frac{3}{4}'' = 1'-0''$

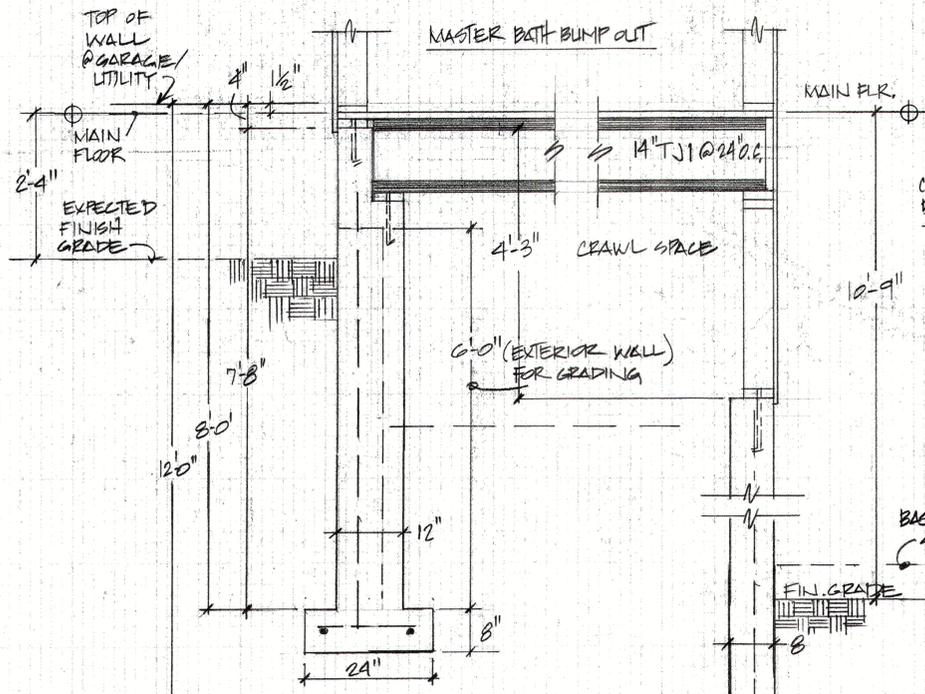

Ⓔ DETAIL $\frac{3}{4}'' = 1'-0''$

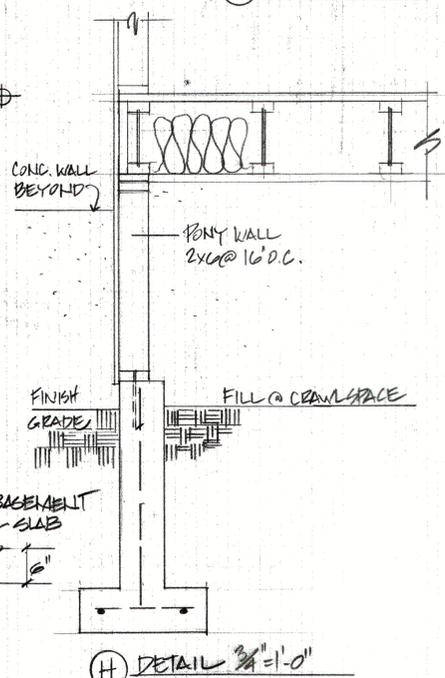


Ⓕ DETAIL $\frac{3}{4}'' = 1'-0''$

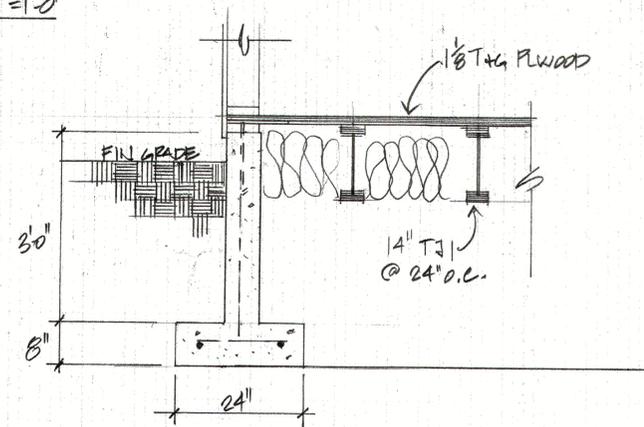


Ⓖ DETAIL $\frac{3}{4}'' = 1'-0''$

Ⓖ DETAIL $\frac{3}{4}'' = 1'-0''$


FOUNDATION DETAILS
 $\frac{3}{4}'' = 1'-0''$

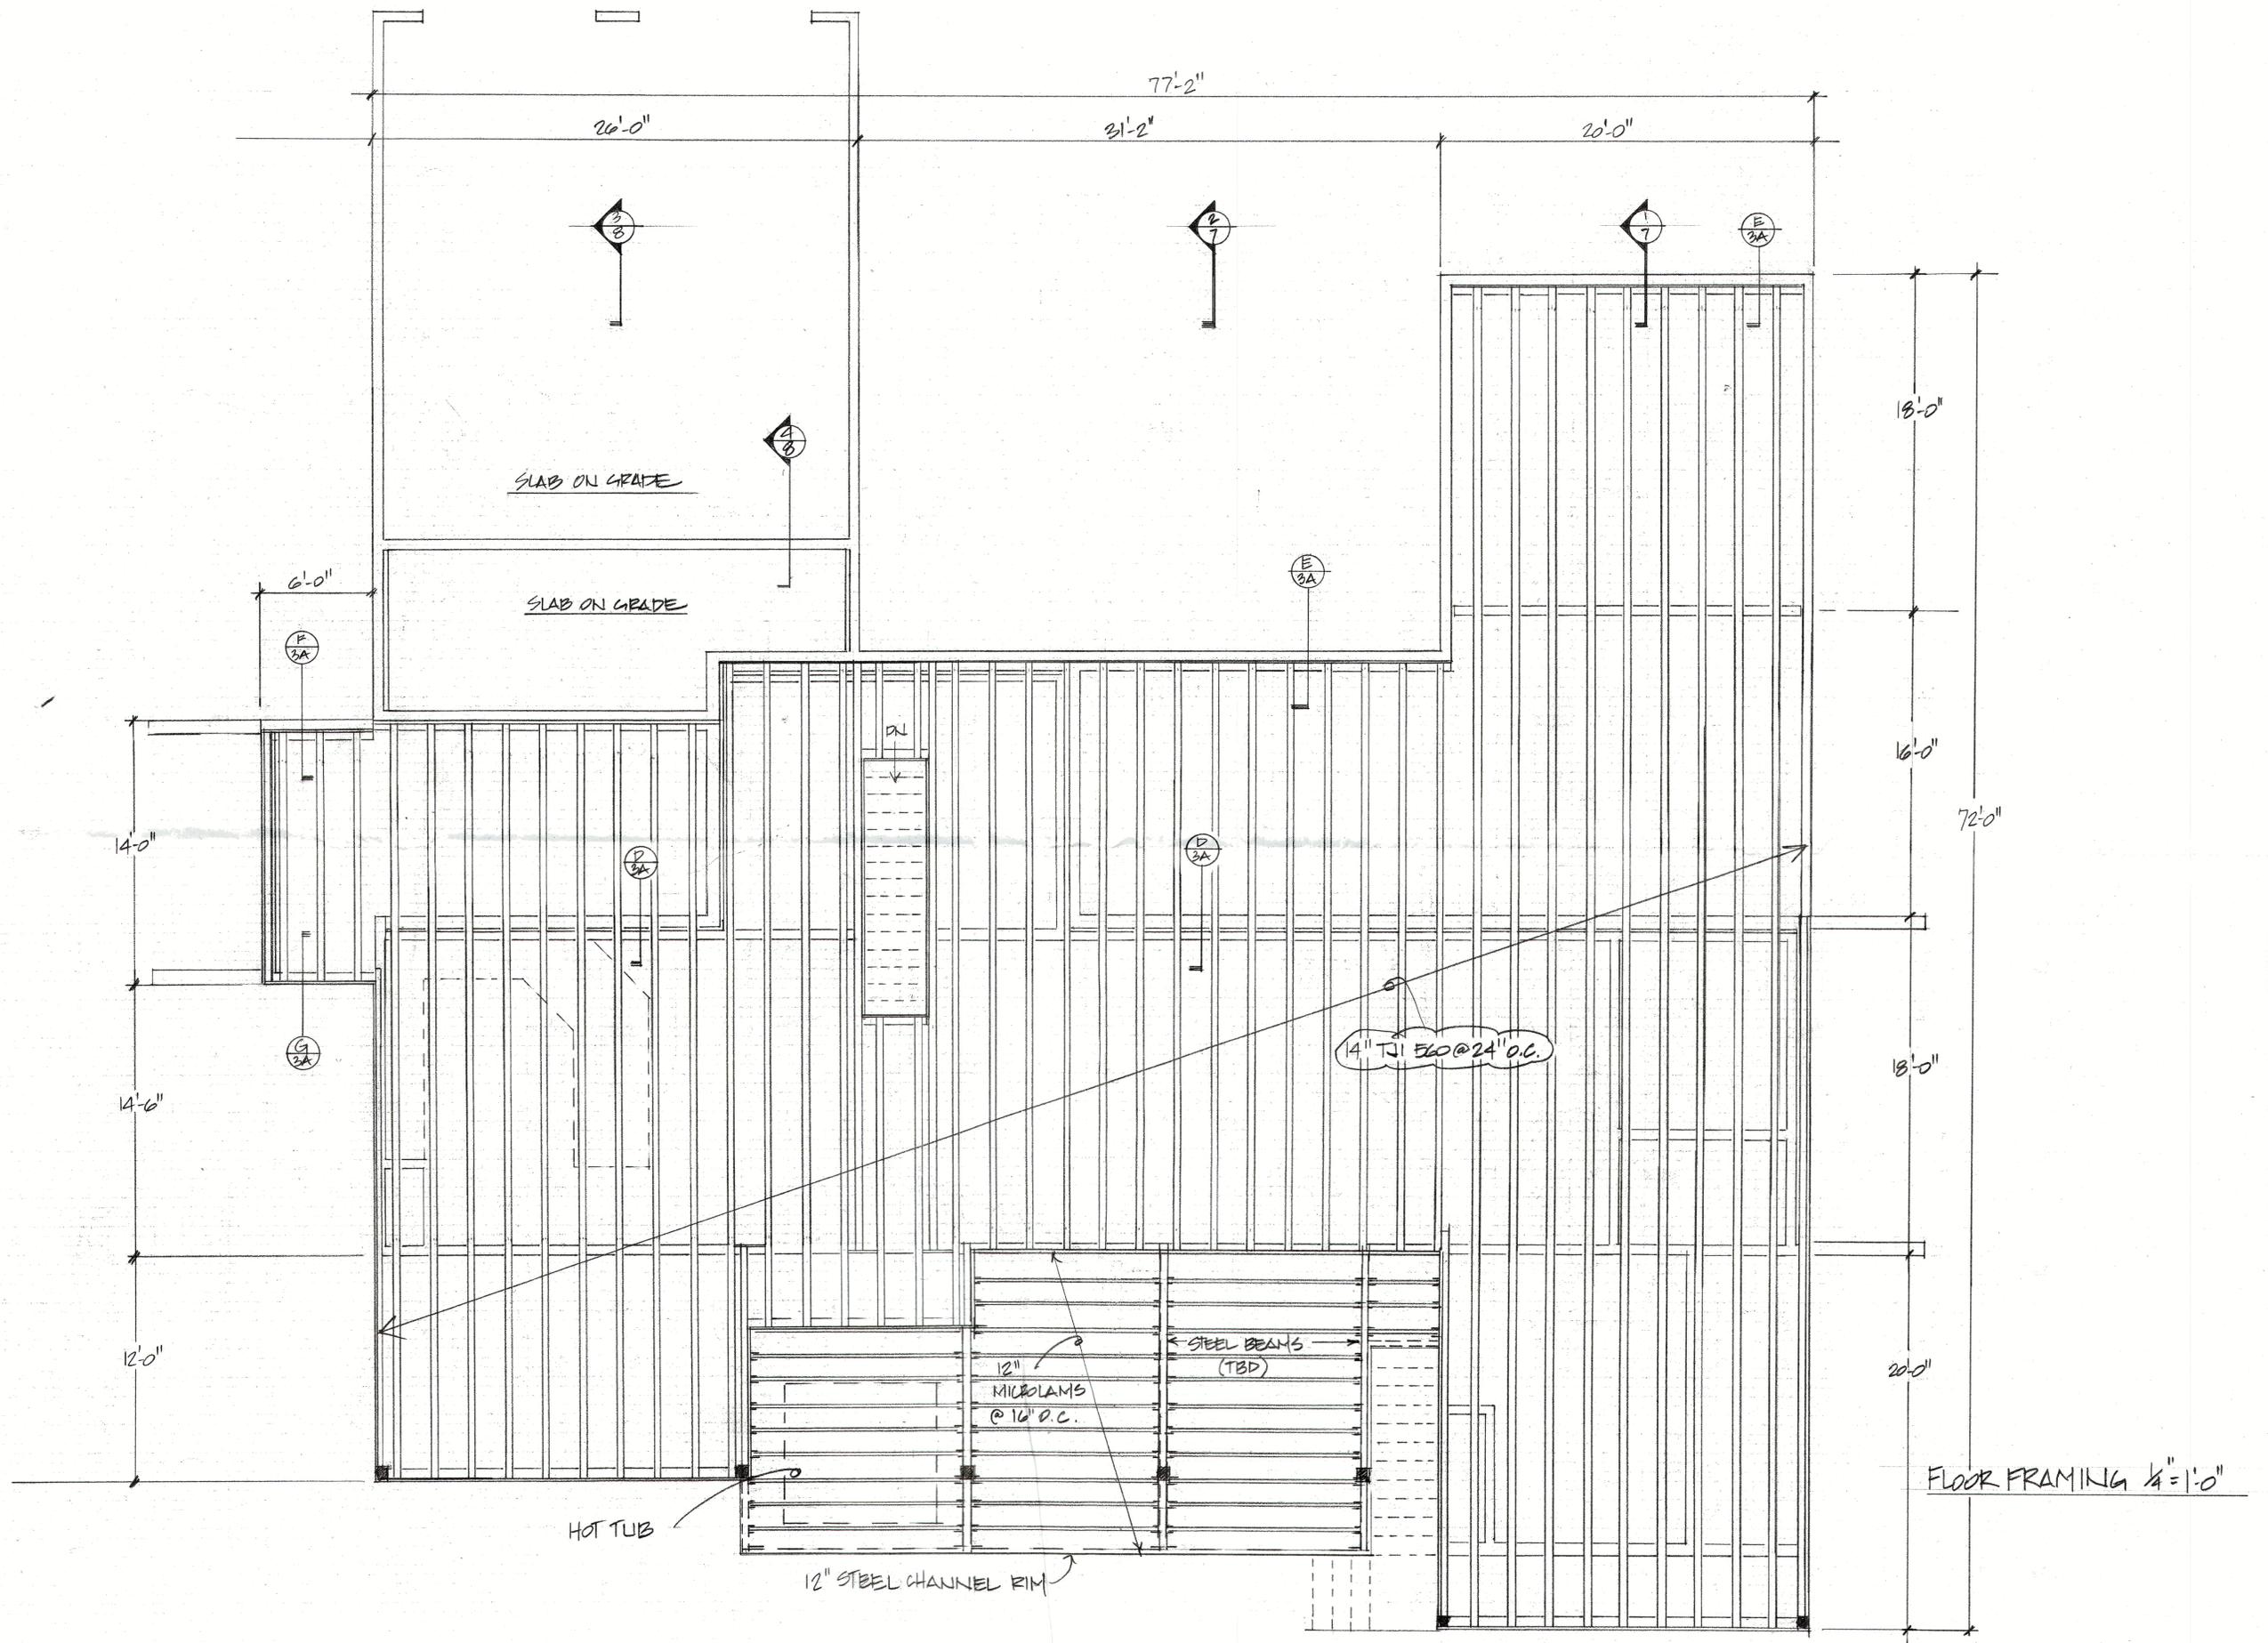

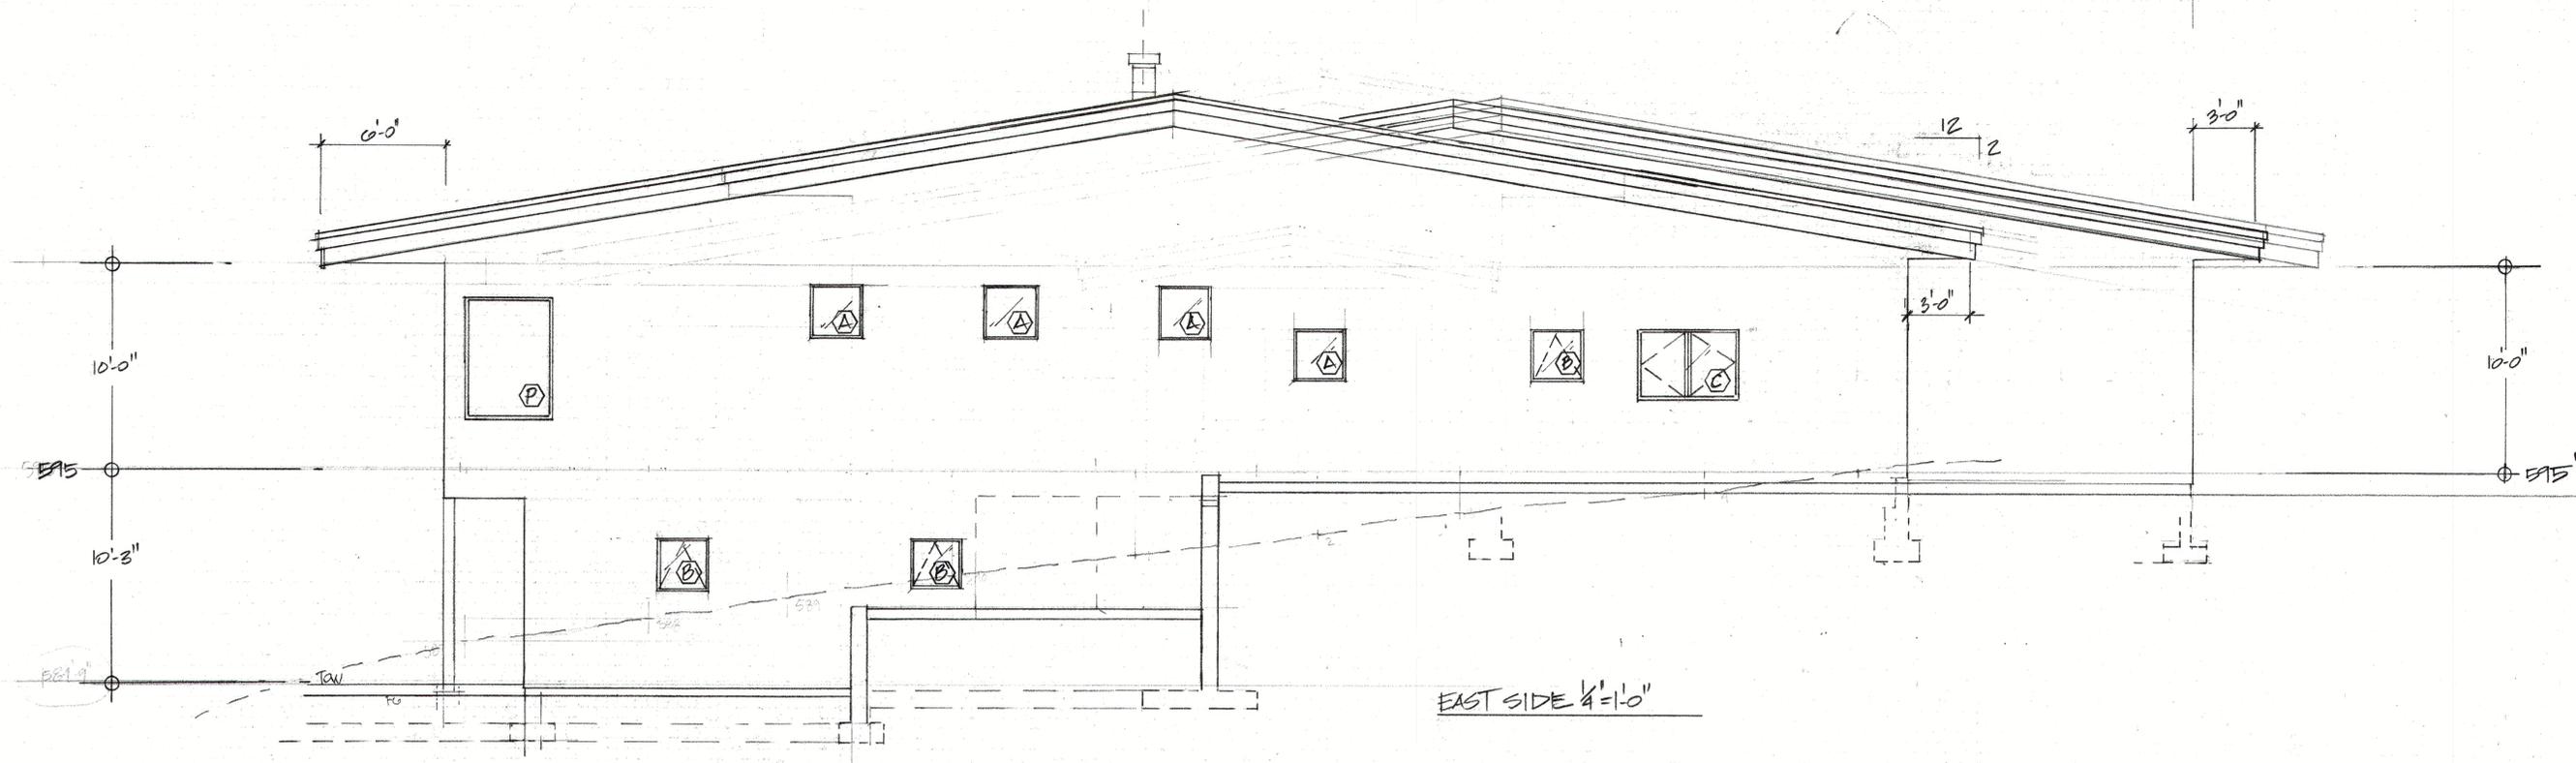



EAST SIDE 1/4" = 1'-0"


NOTE: ALL SIDING
WILL BE NON COMBUSTIBLE
FIBER CEMENT TBD

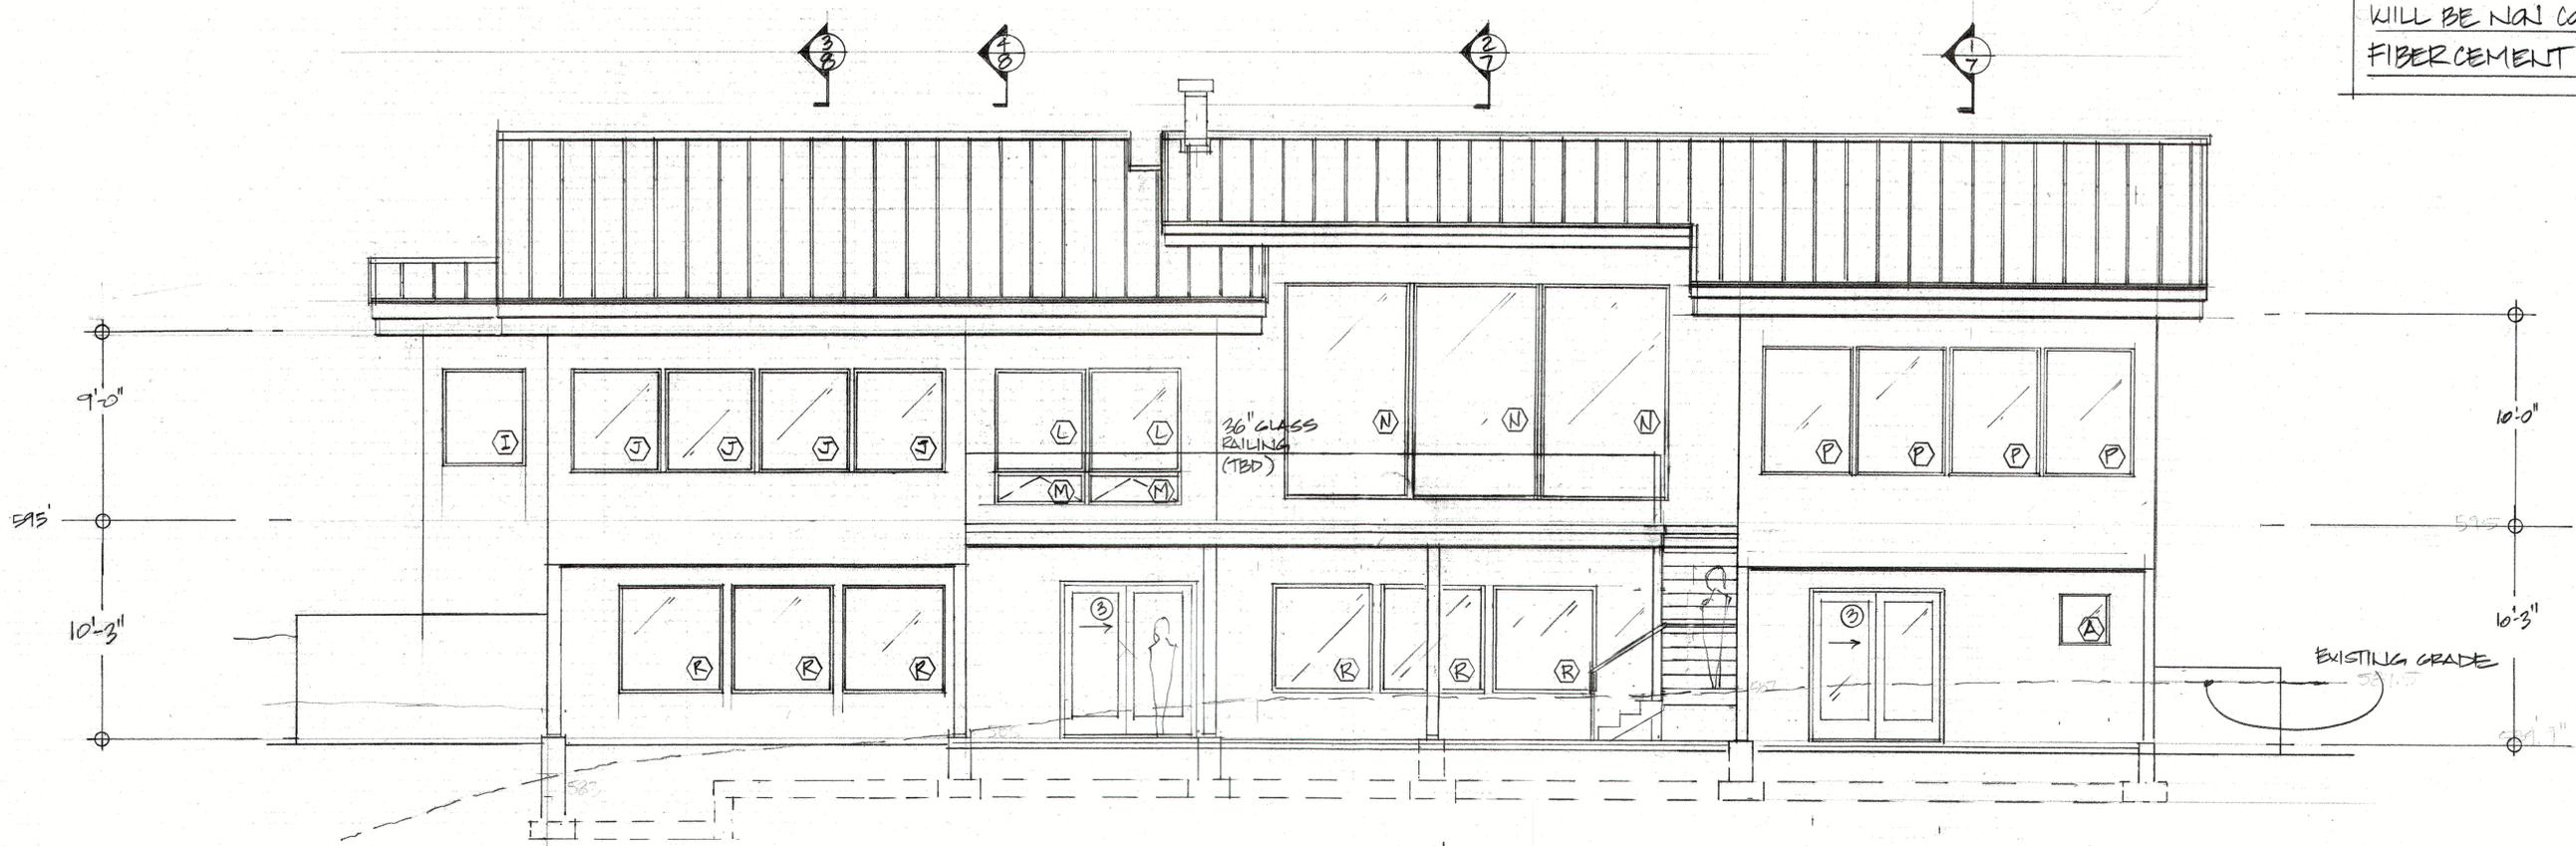


SOUTH SIDE 1/4" = 1'-0"

EXISTING GRADE

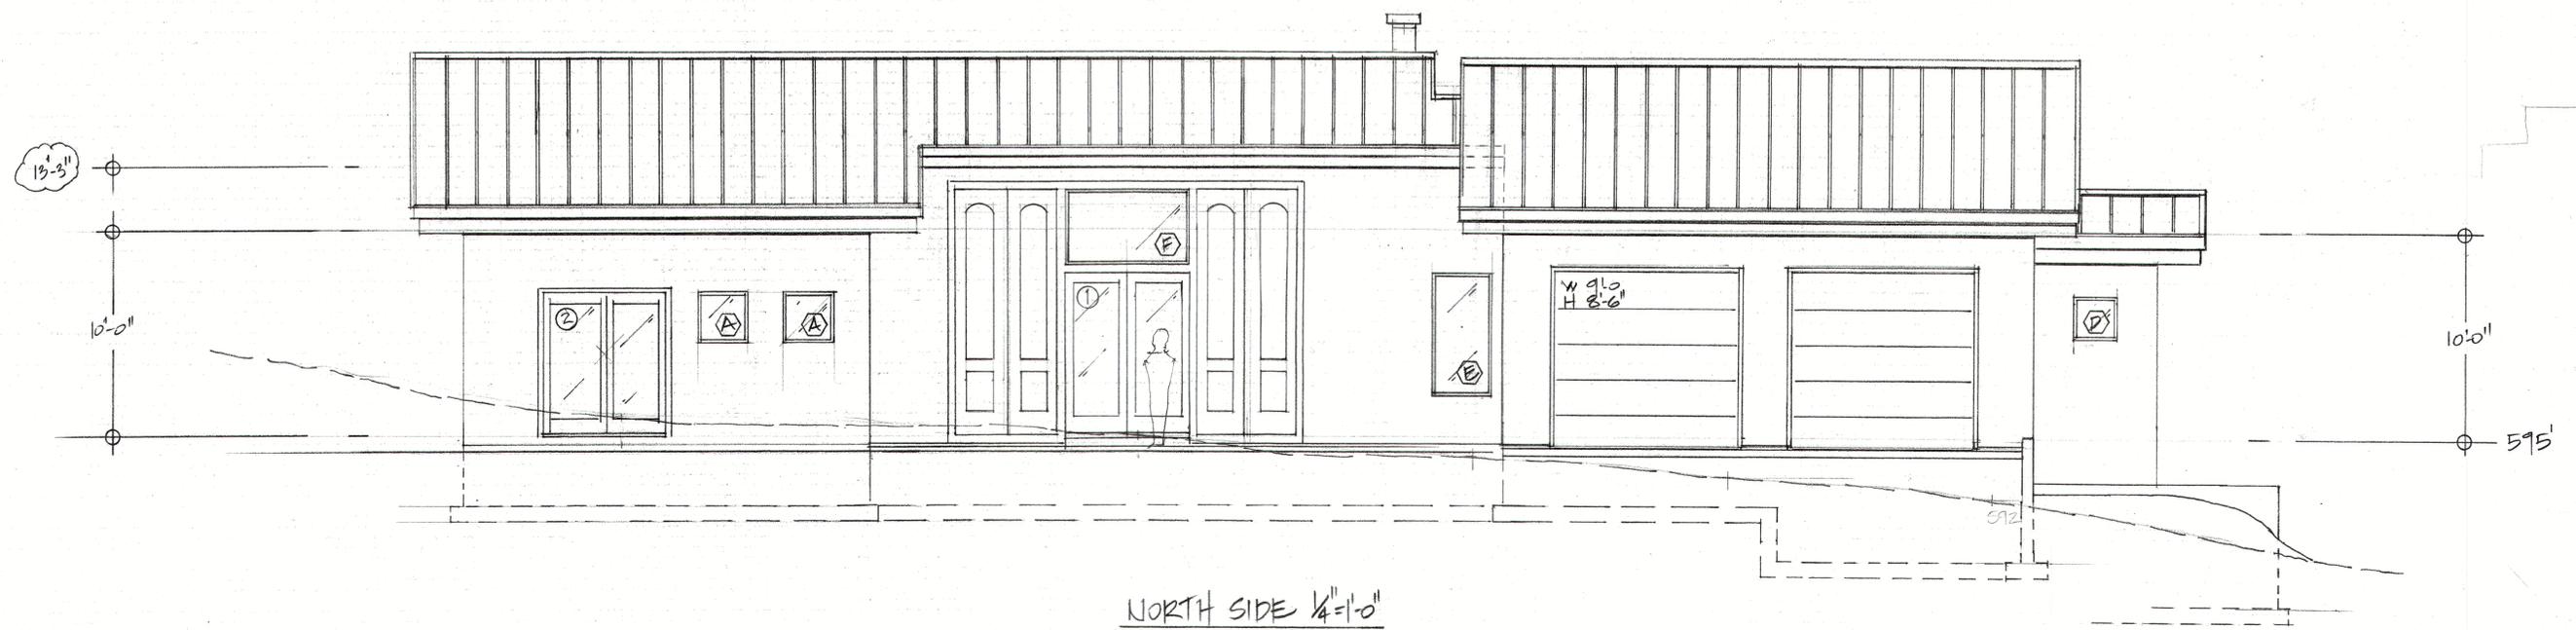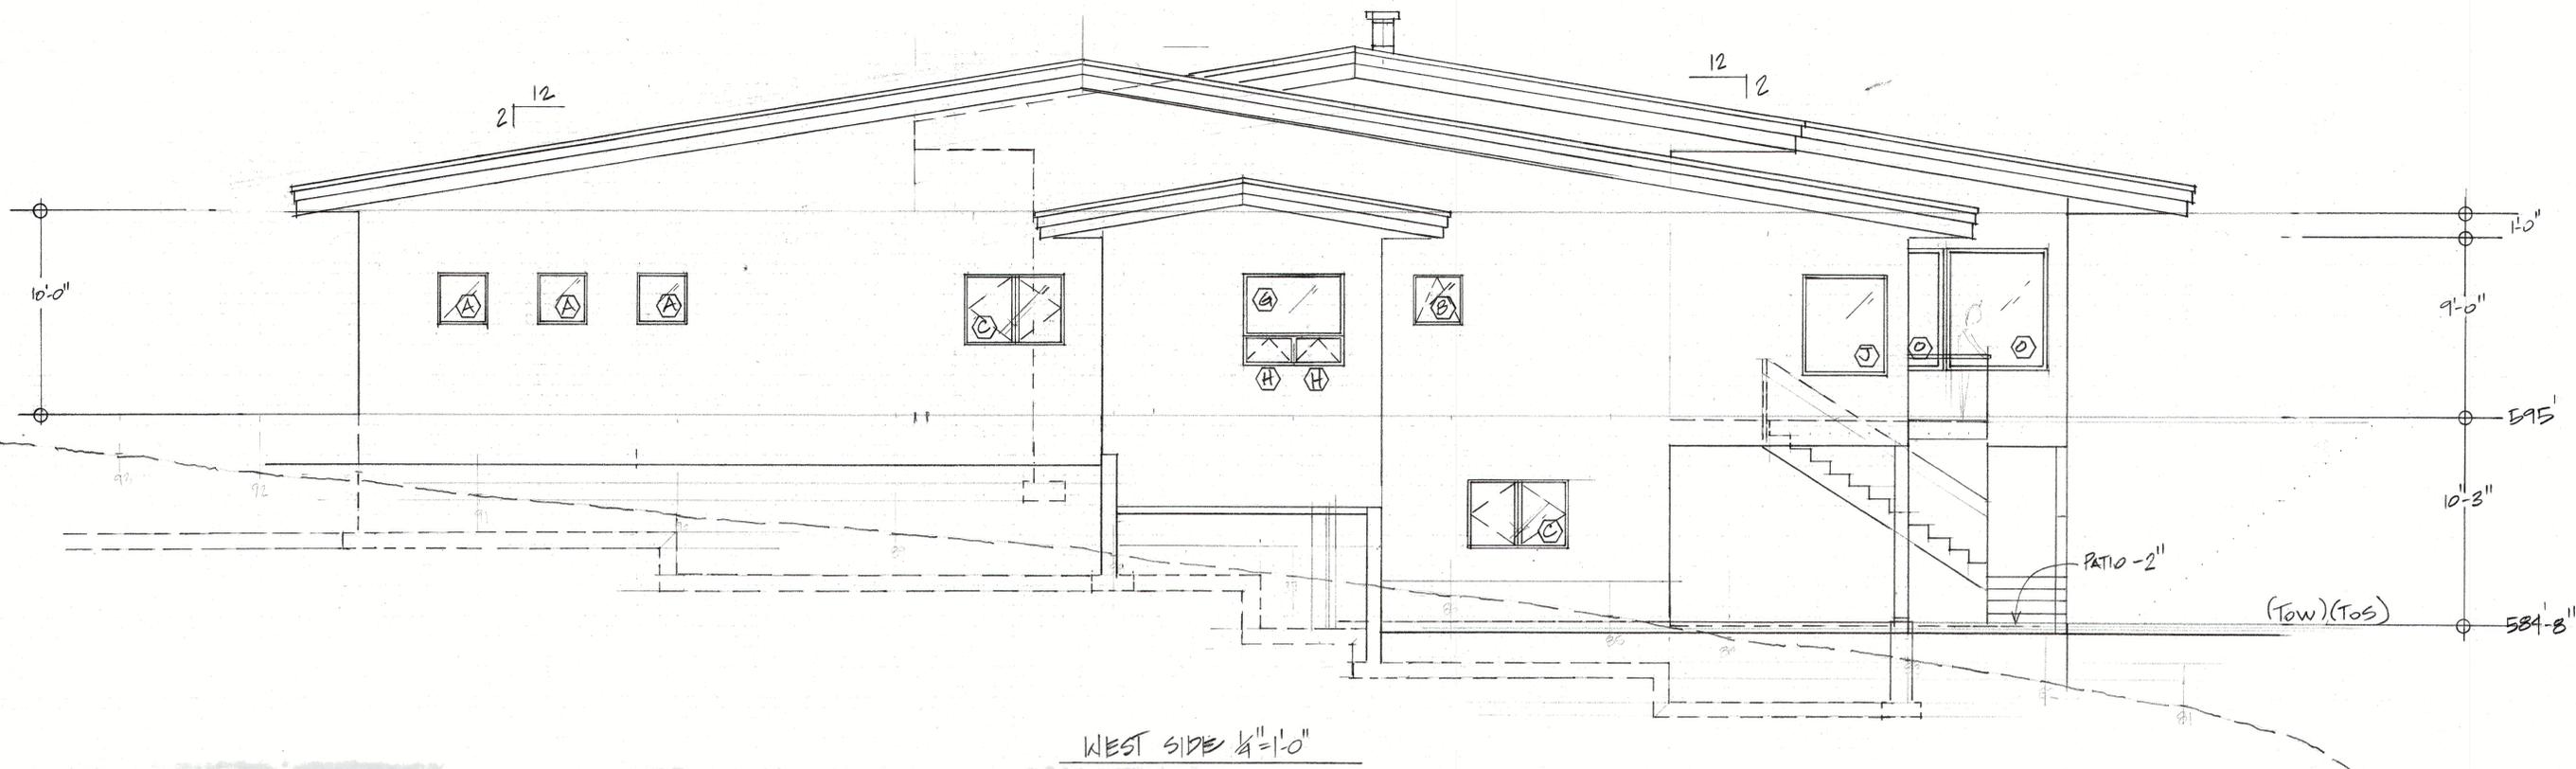

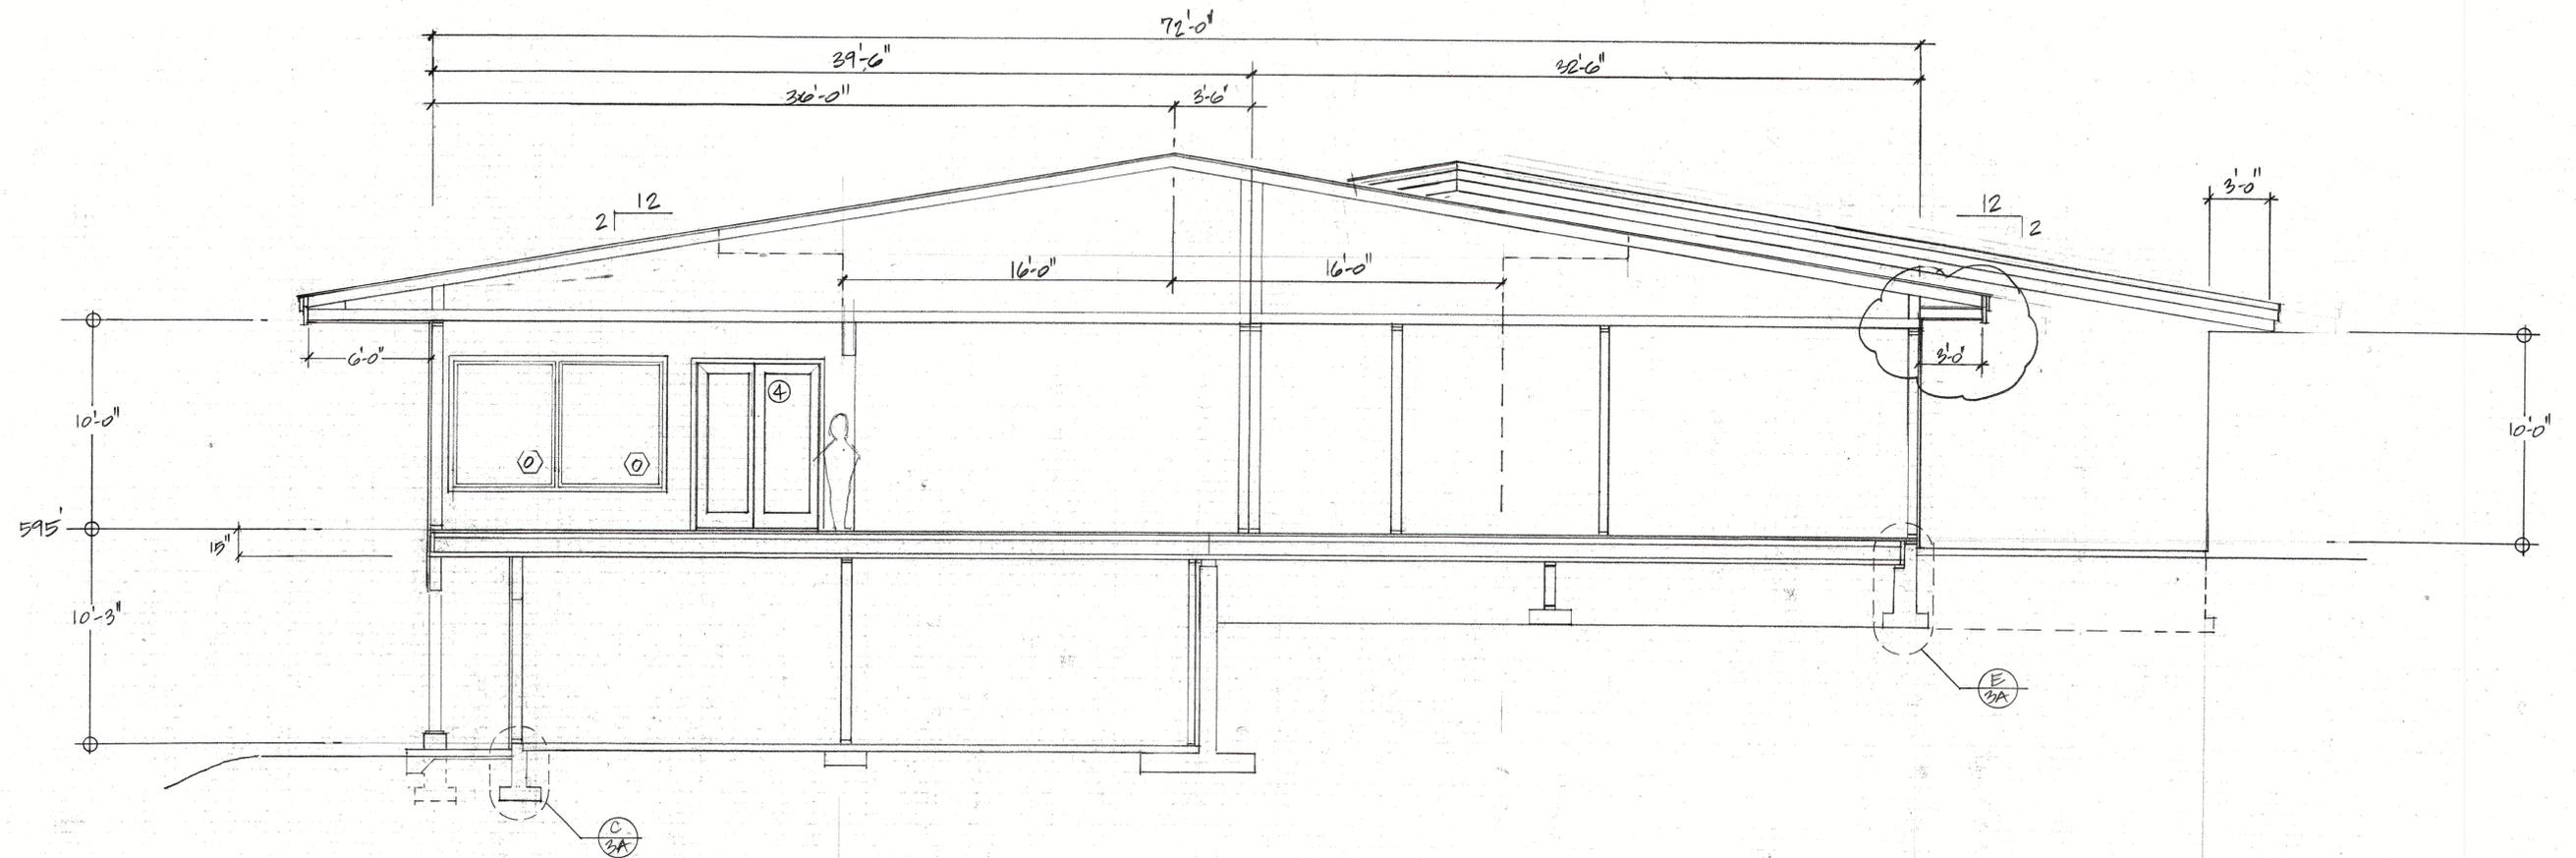


① SECTION $\frac{1}{4}''=1'-0''$

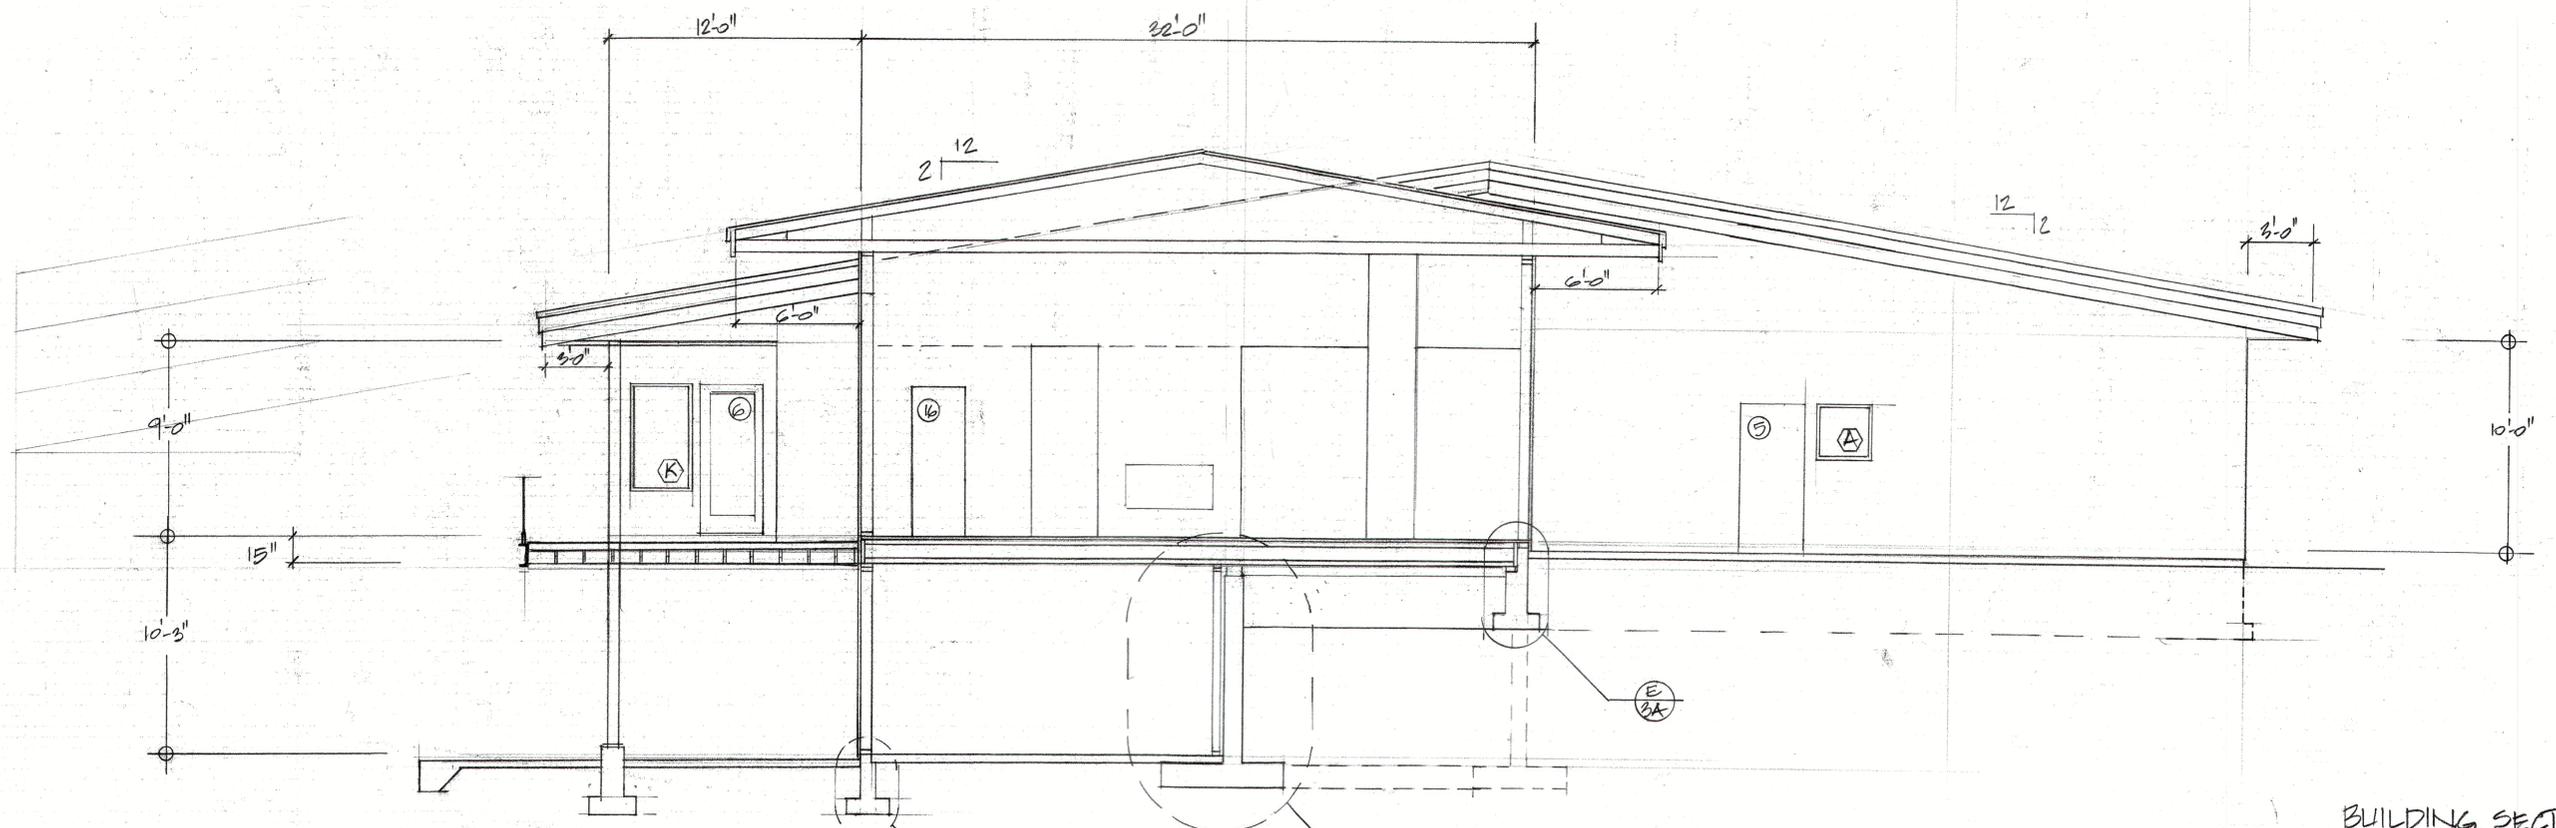


② SECTION $\frac{1}{4}''=1'-0''$


BUILDING SECTIONS
 $\frac{1}{4}''=1'-0''$

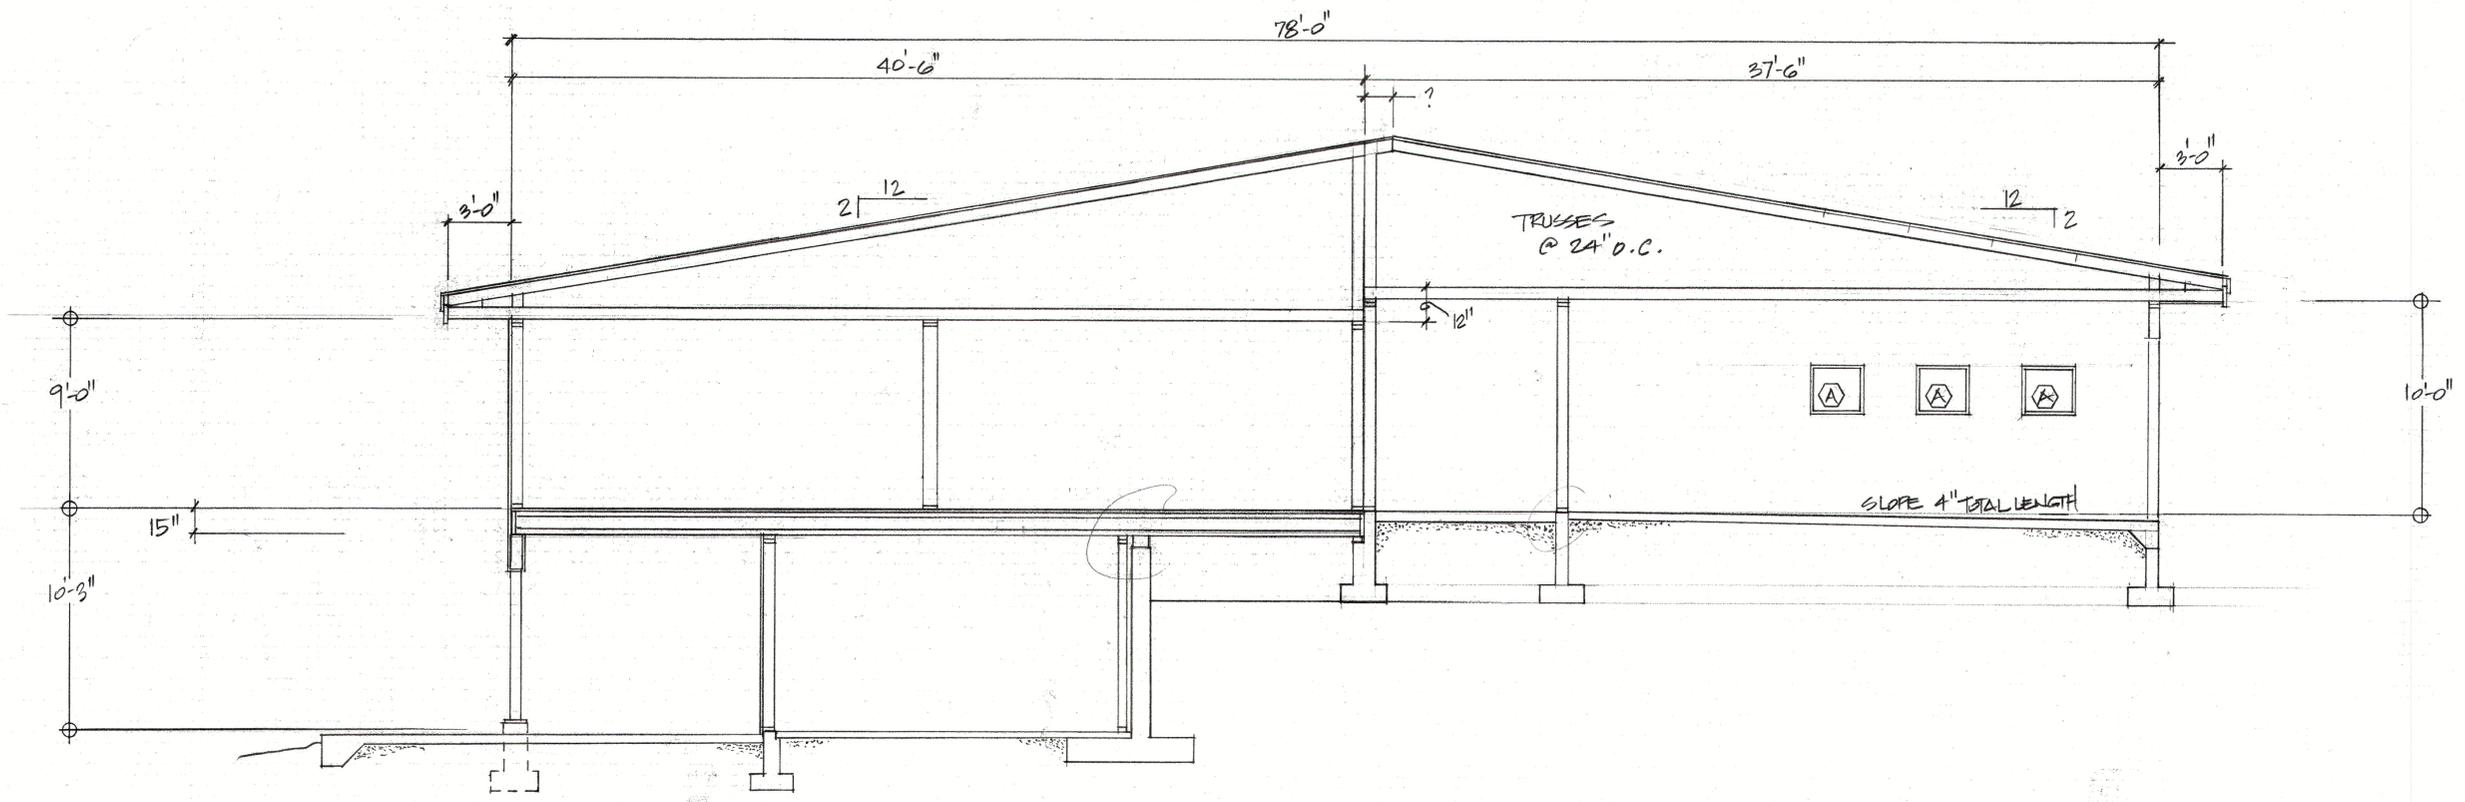

③ SECTION $\frac{1}{4}'' = 1'-0''$

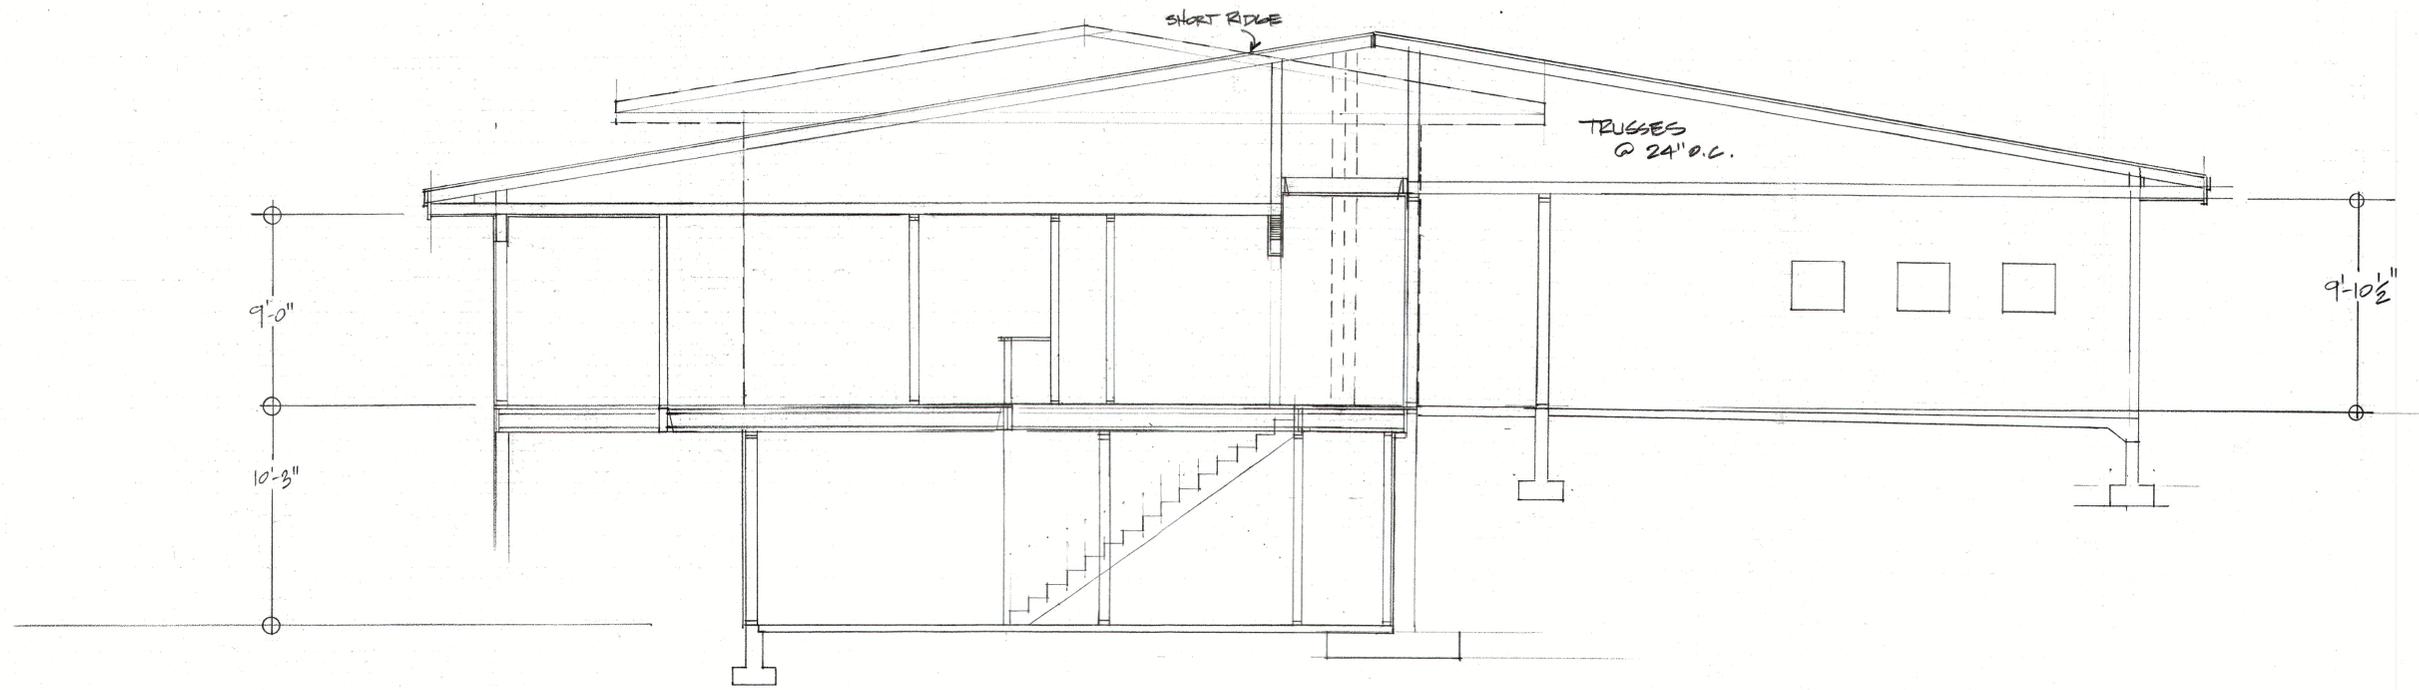


④ SECTION $\frac{1}{4}'' = 1'-0''$

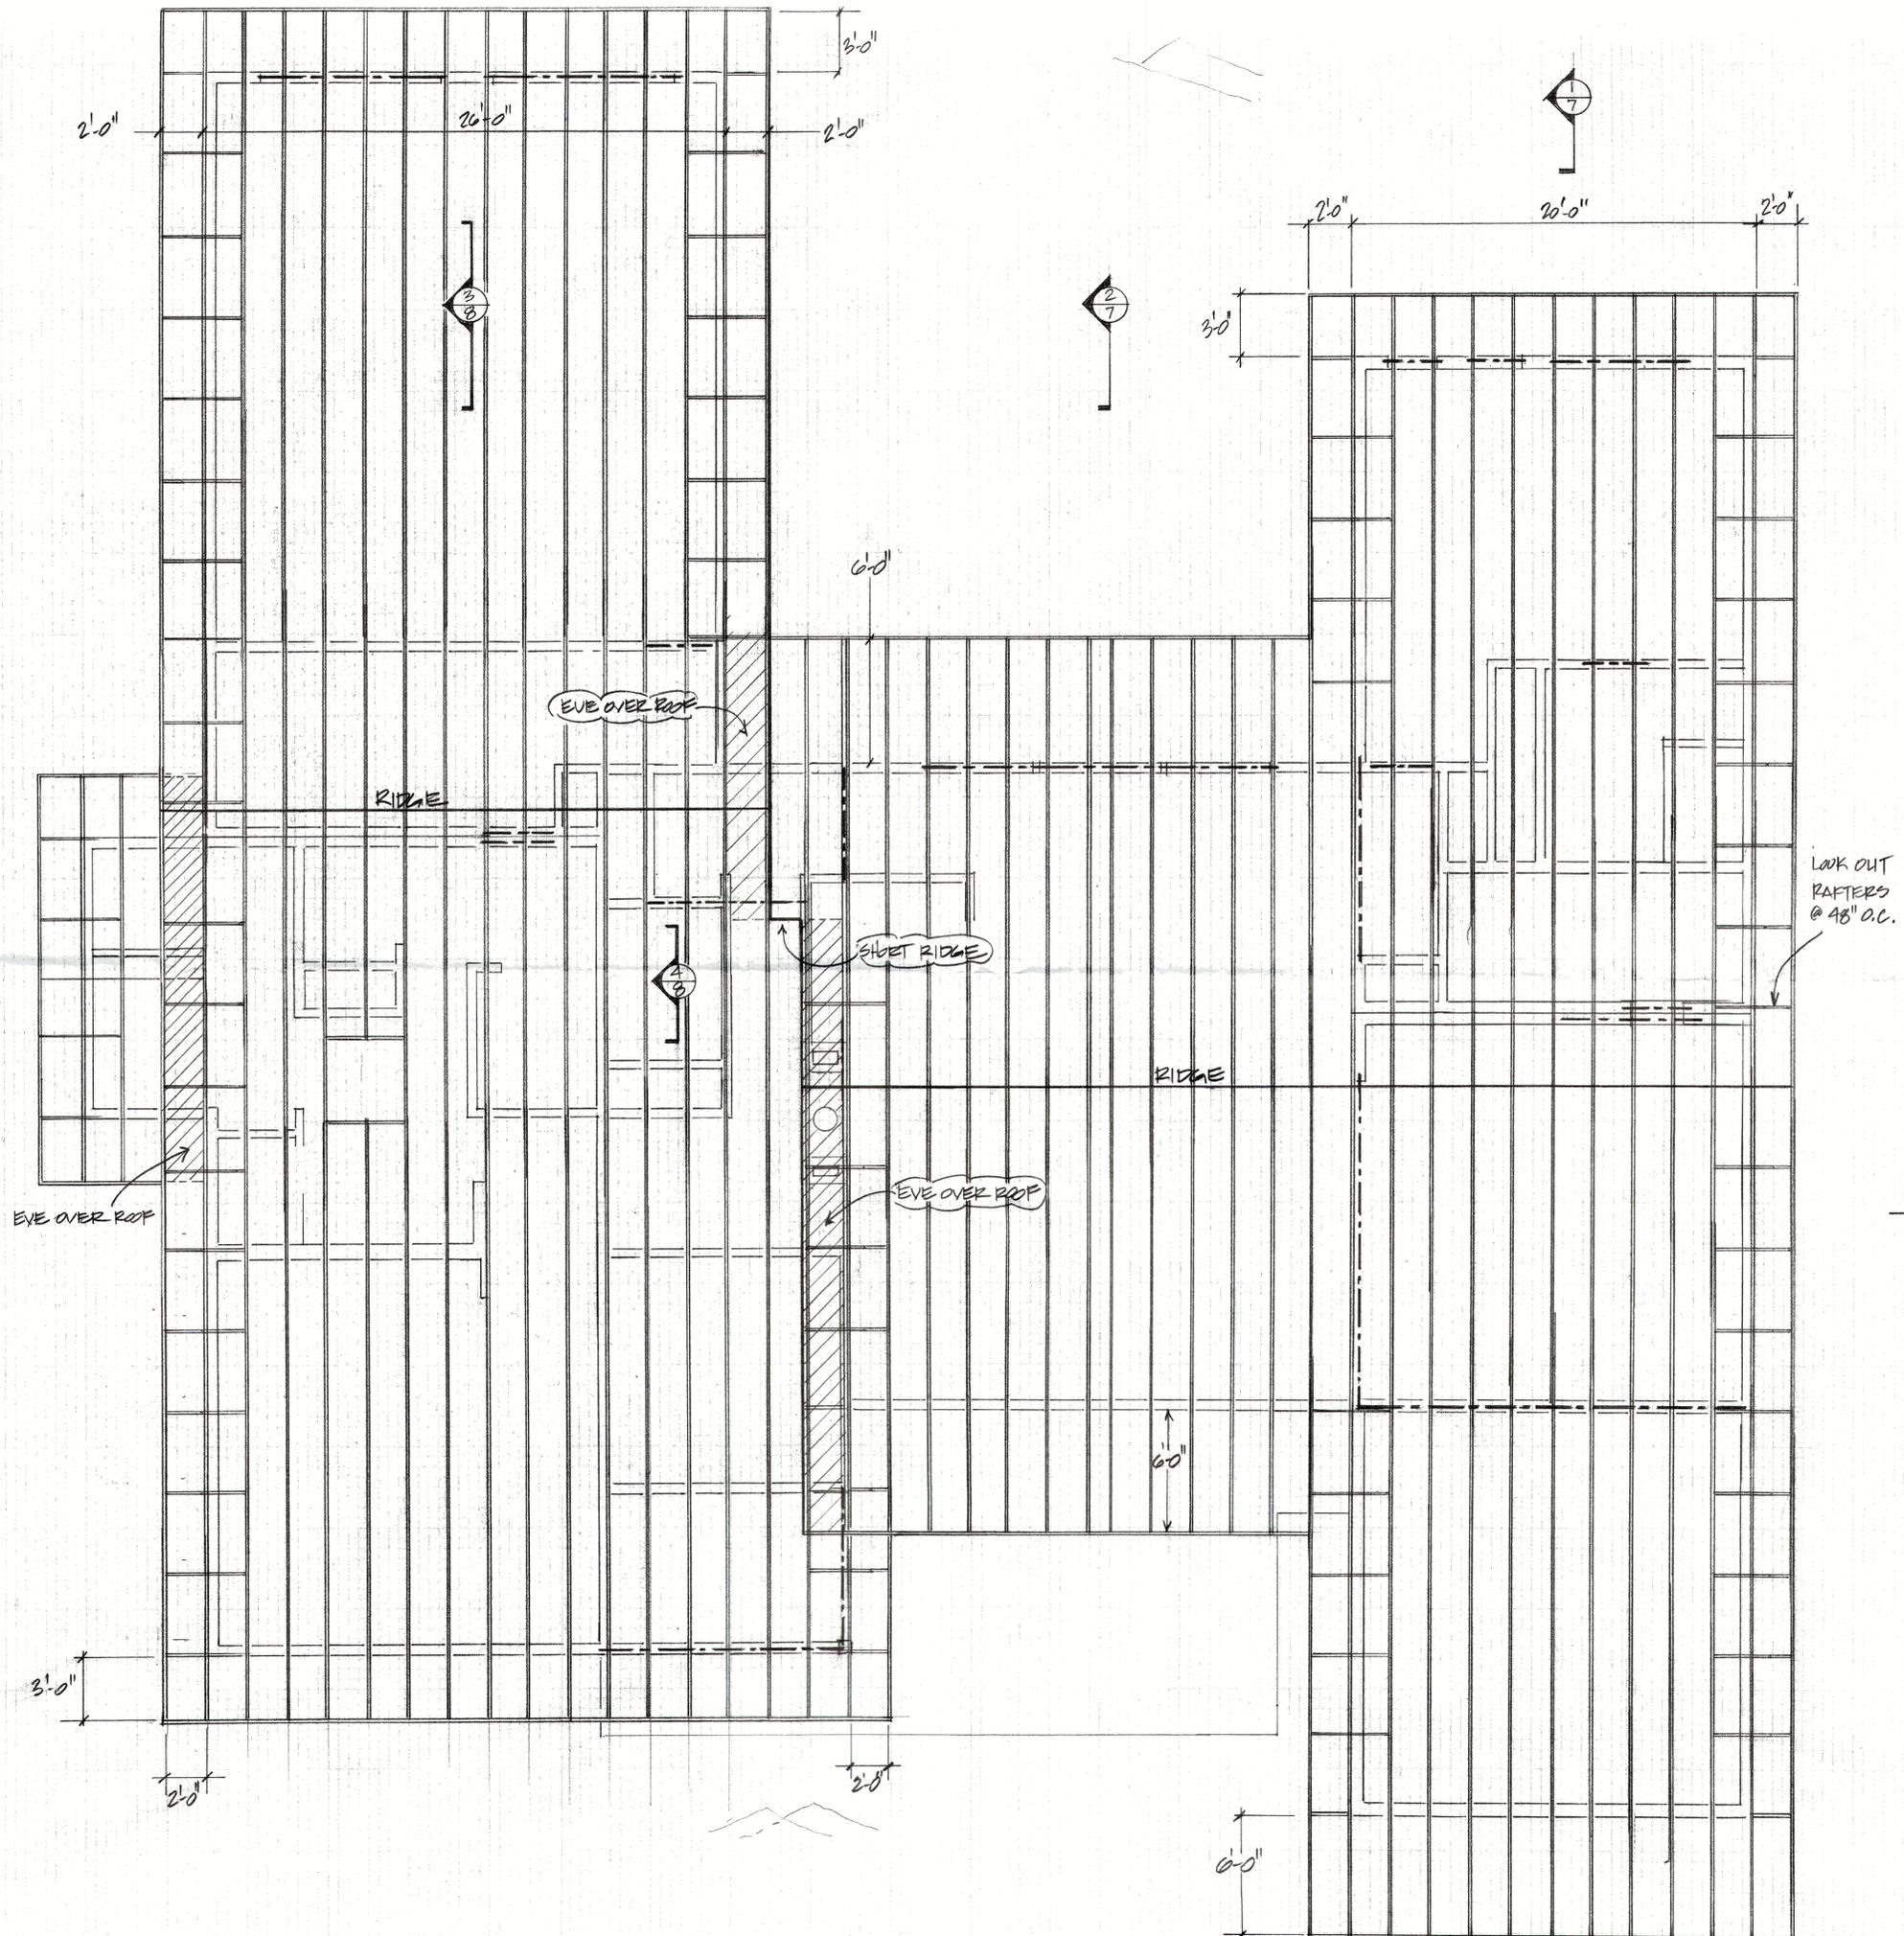


PREMANUFACTURED TRUSSES
@ 24" O.C.

ROOF FRAMING PLAN
1/4" = 1'-0"

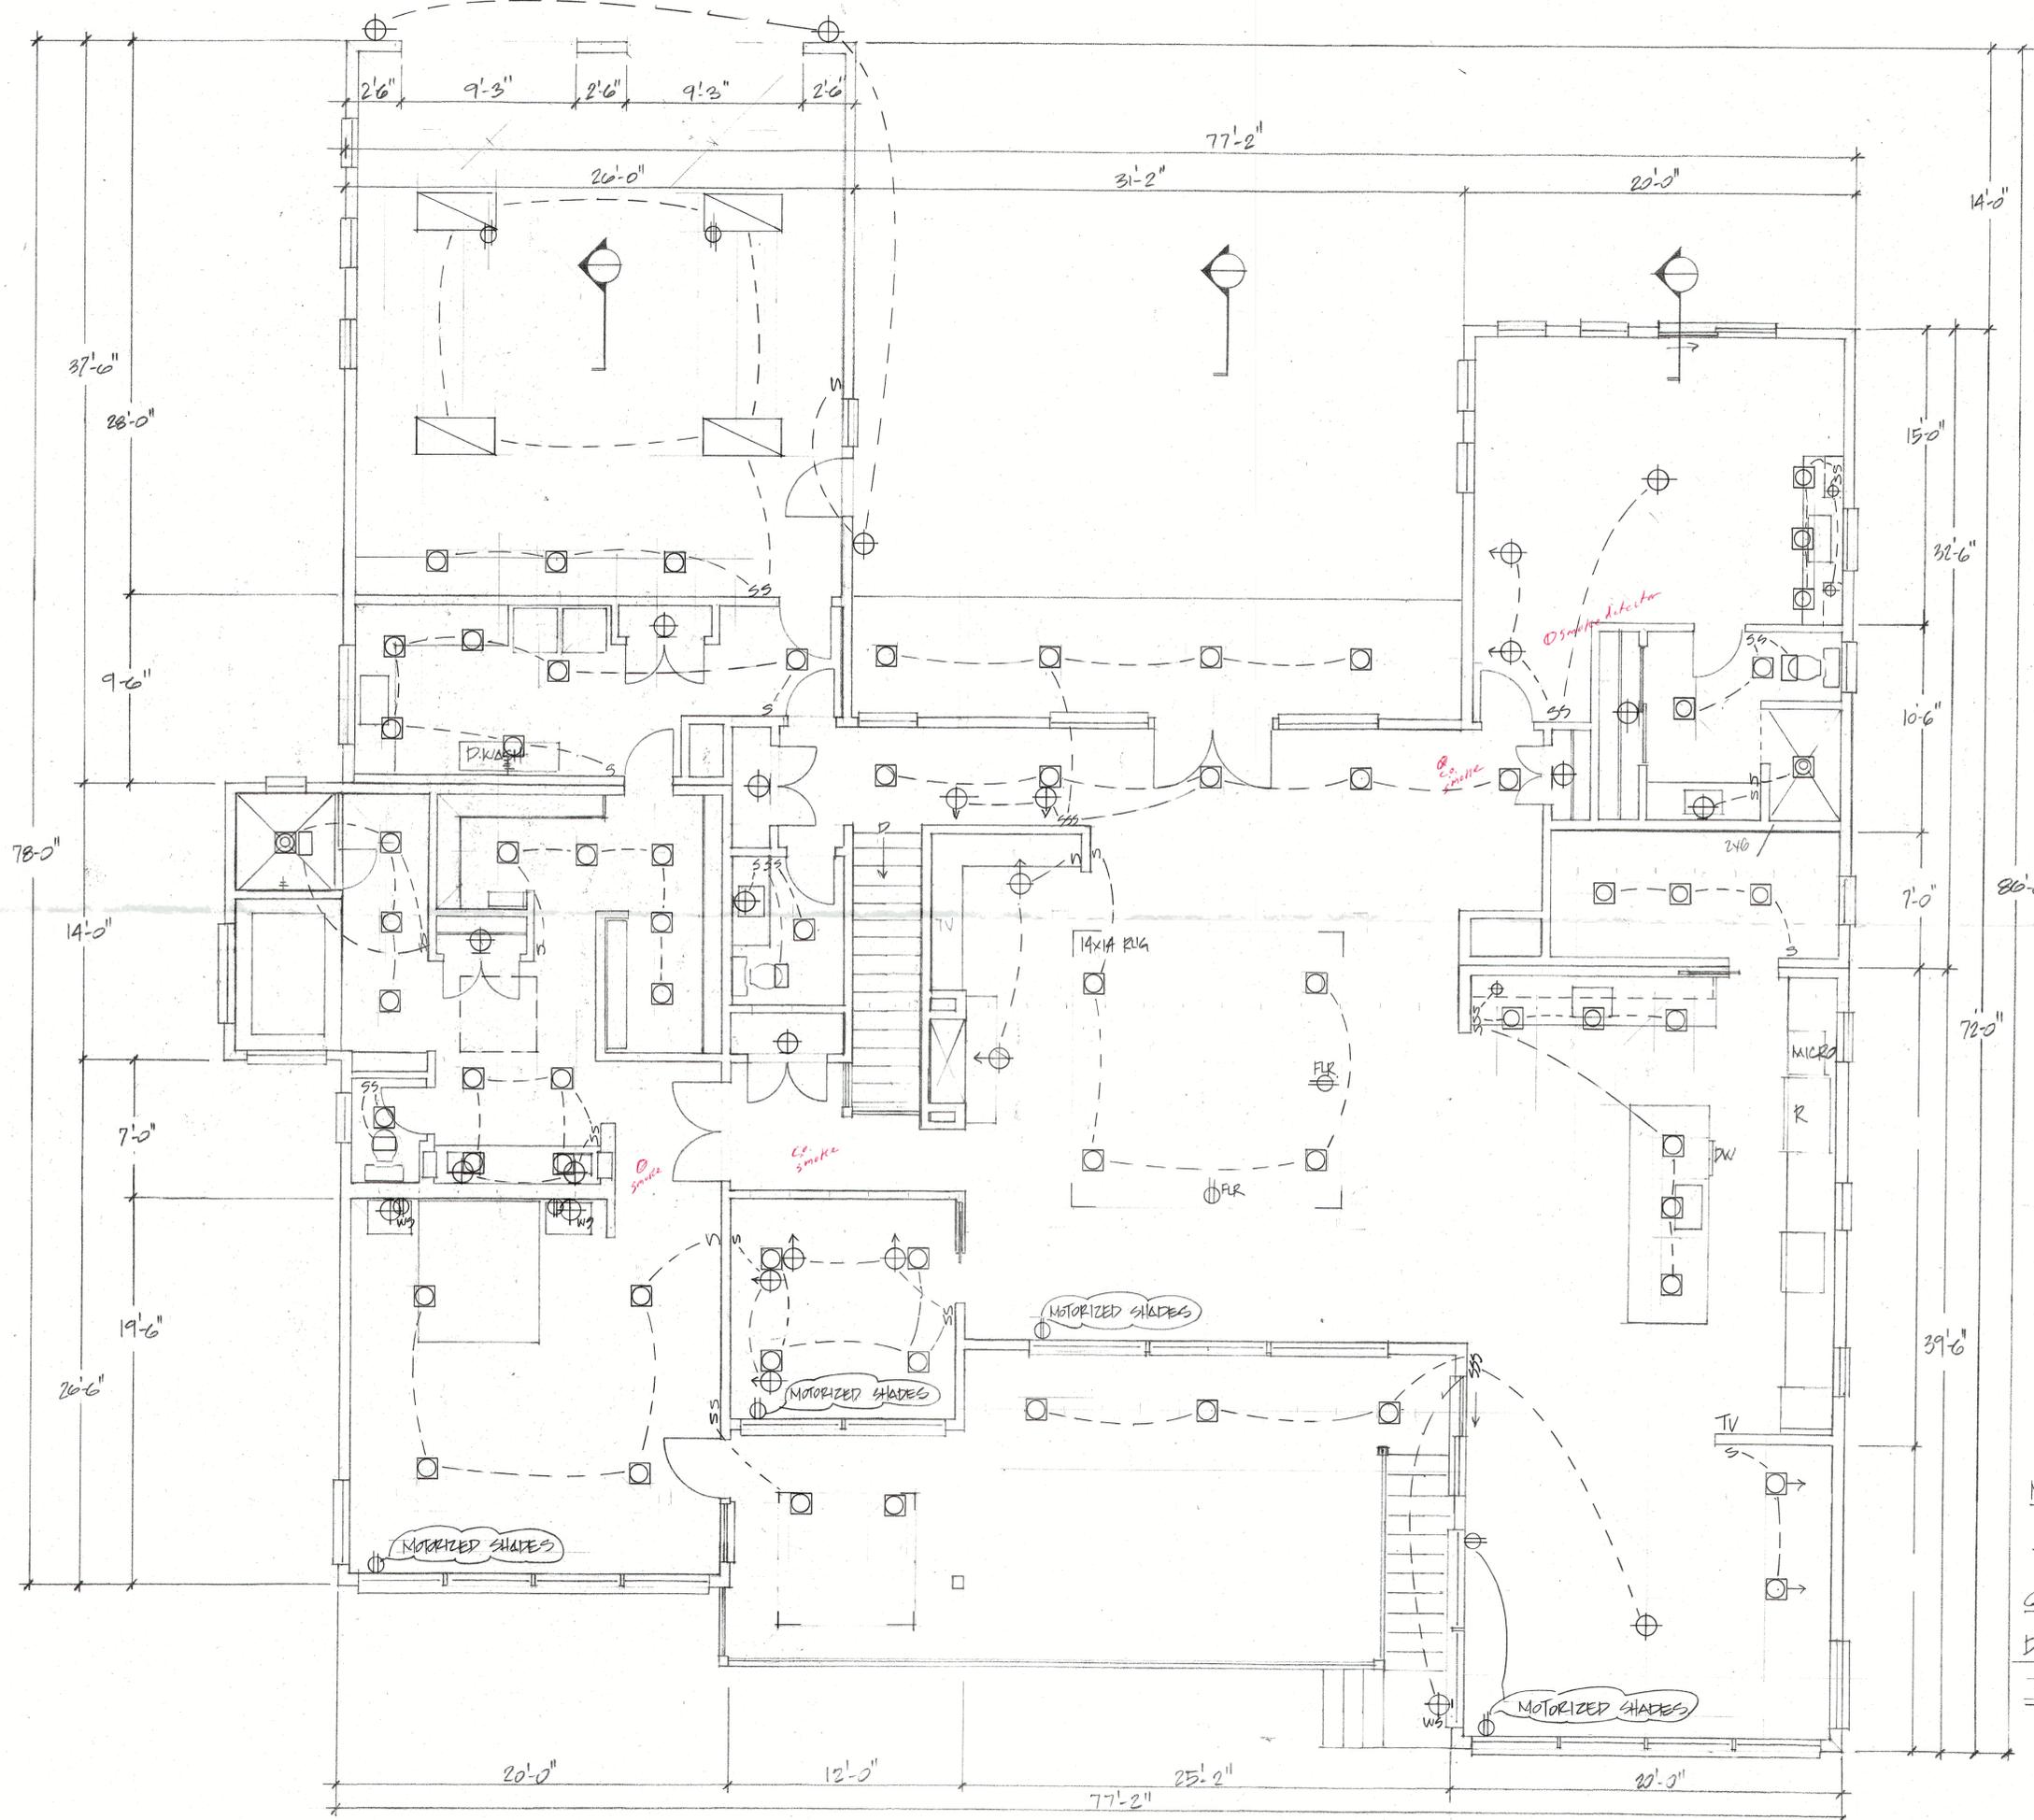

MAIN FLOOR PLAN 1/4"=1'-0"
 3768 S.F.
 GARAGE 728 S.F.
 DECK 544 S.F.
 PRELIMINARY LIGHTING
 4/10

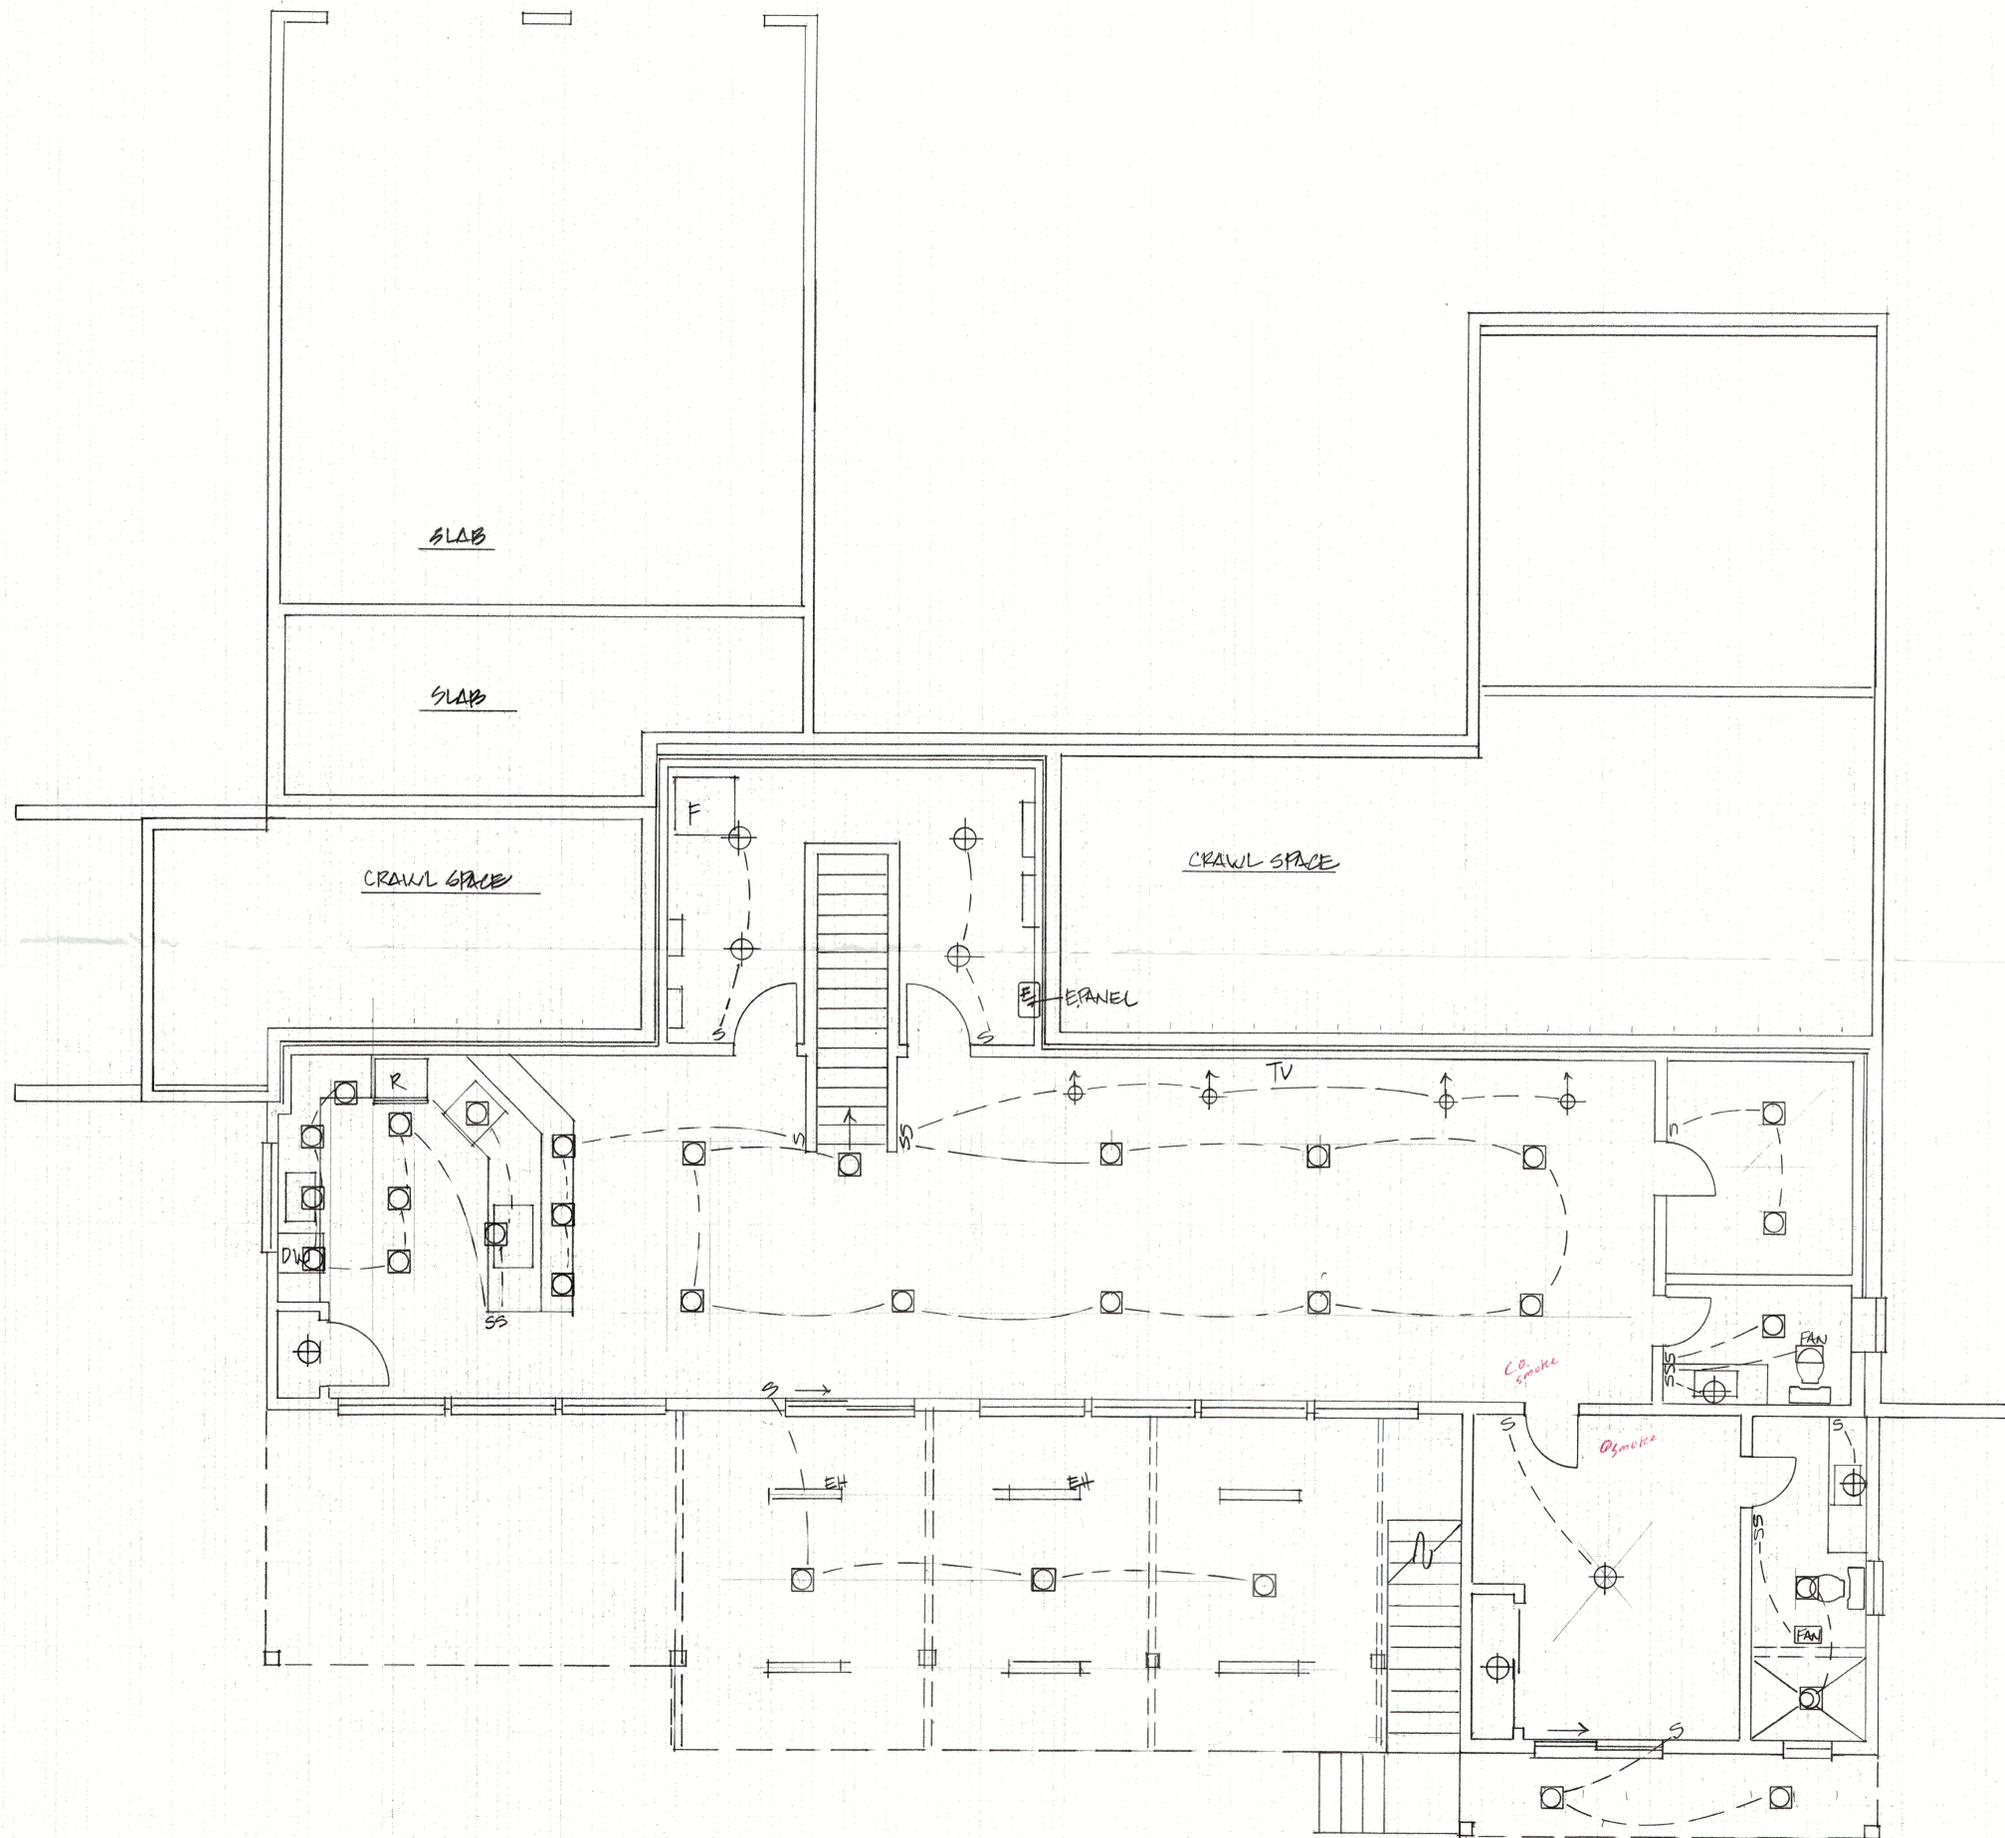

LIGHTING LAYOUT BASEMENT
 1/4" = 1'-0"